


TOWNSHIP 7 N., RANGE 9 W.

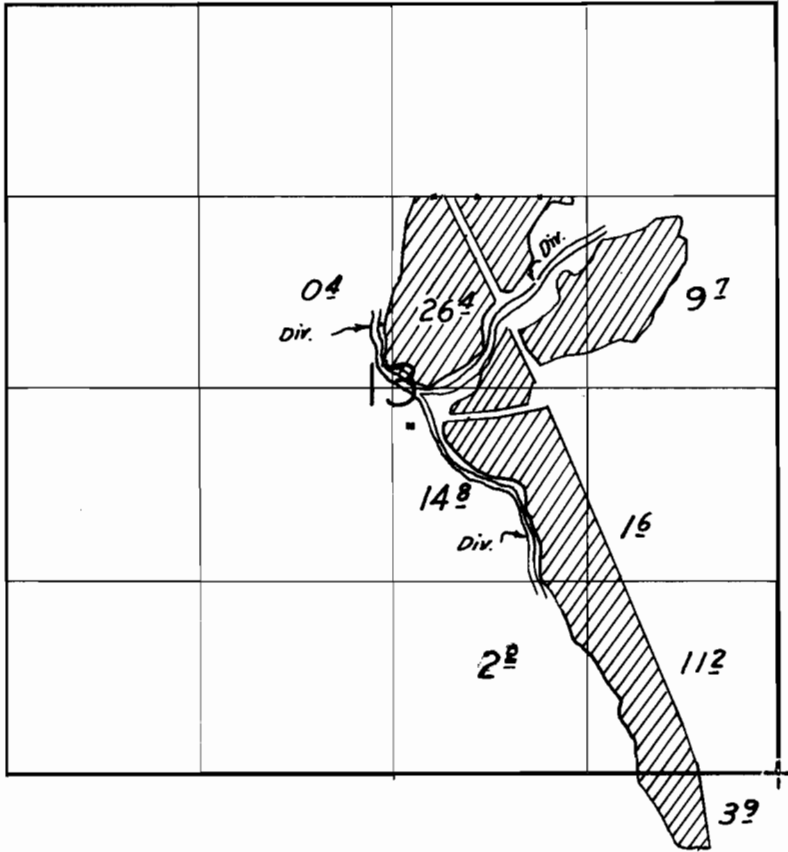

FINAL PROOF SURVEY
UNDER

Application No. 17298 Permit No. 13025

IN NAME OF

The First National Bank of Portland

Surveyed Aug. 11, 1941, by Chester Cummings