


SECTION

TOWNSHIP 18 S, RANGE 3 W, W. M.

North

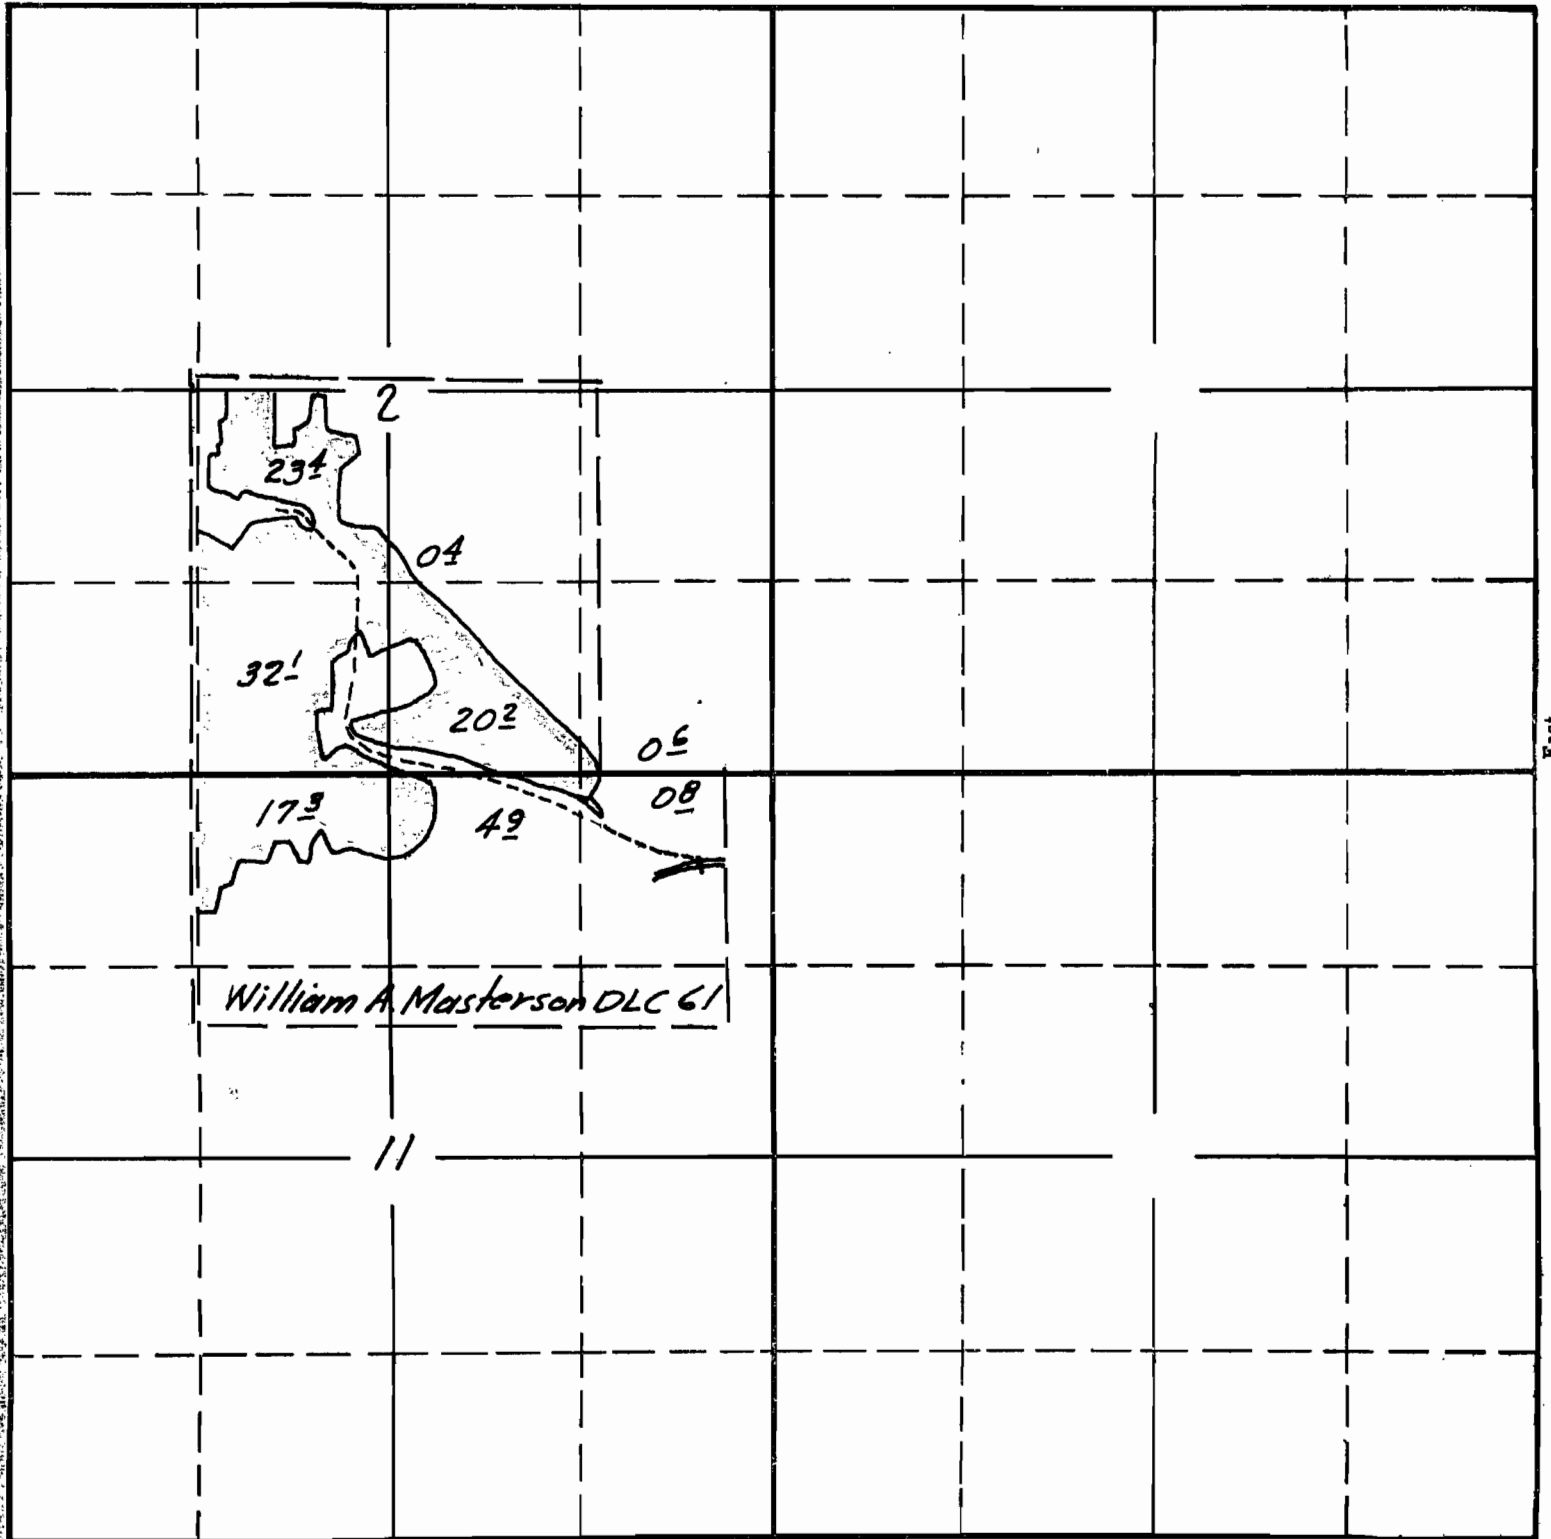

FINAL PROOF SURVEY
UNDER

South

APPLICATION No.
PERMIT No.

Application No. 17327 Permit No. 13041
IN NAME OF

Ben F. Dorris

Surveyed 19, by