


TOWNSHIP 12 S. RANGE 11W.

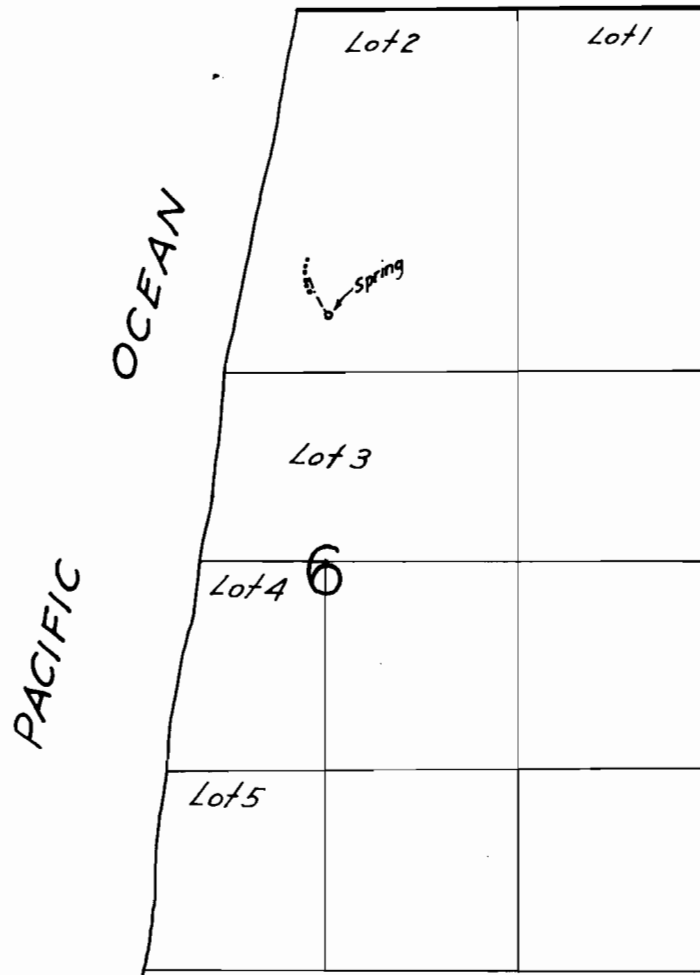

FINAL PROOF SURVEY

UNDER

Application No. 17337 Permit No. 13048

IN NAME OF

Roy Boober

Surveyed Aug. 7, 1941, by Ed. Humm