


13058

TOWNSHIP 2N., RANGE 10E.

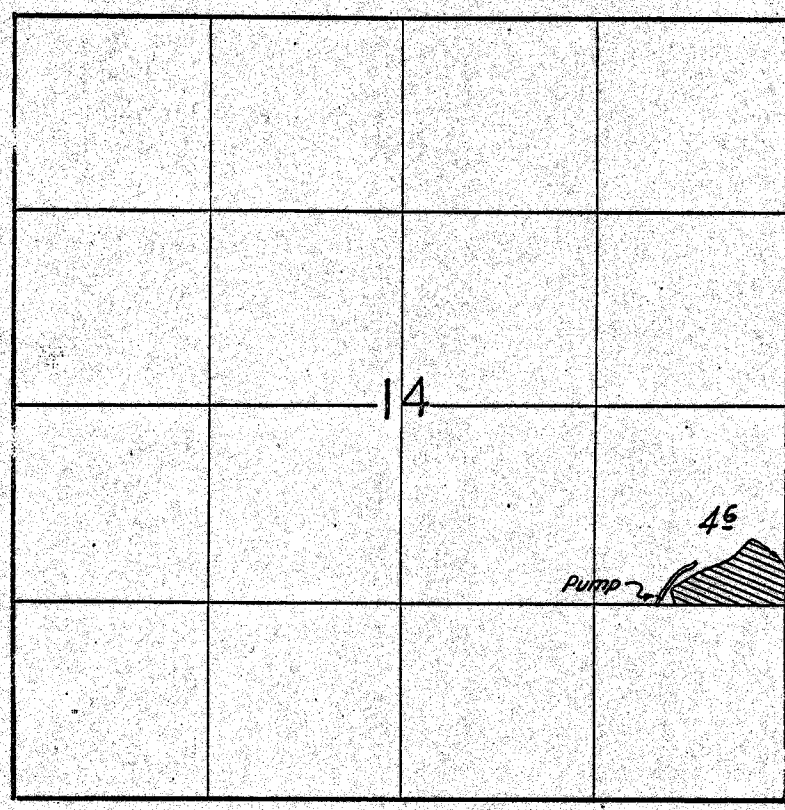

FINAL PROOF SURVEY
UNDER

Application No. 17349 ... Permit No. 13058

IN NAME OF

H.S. Galligan

Surveyed July 5, 1941, by Charles Cunningham