


TOWNSHIP 12 S., RANGE 6 W.

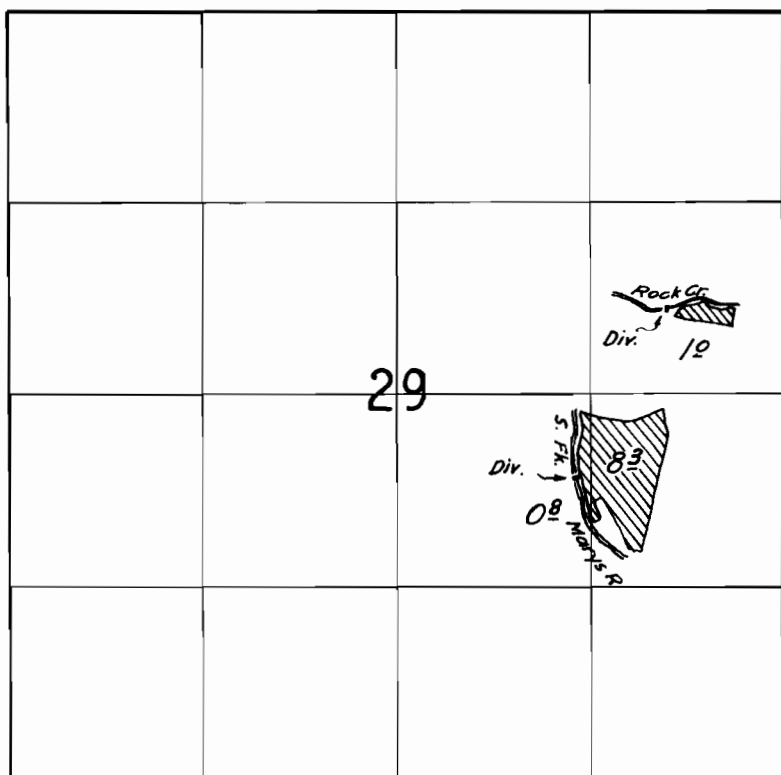

FINAL PROOF SURVEY

UNDER

Application No. 17395 Permit No. 13095

IN NAME OF

Willard & Wallace Totten

Surveyed May 31, 1941, by G. Hummels