


TOWNSHIP 5 N., RANGE 10 W.

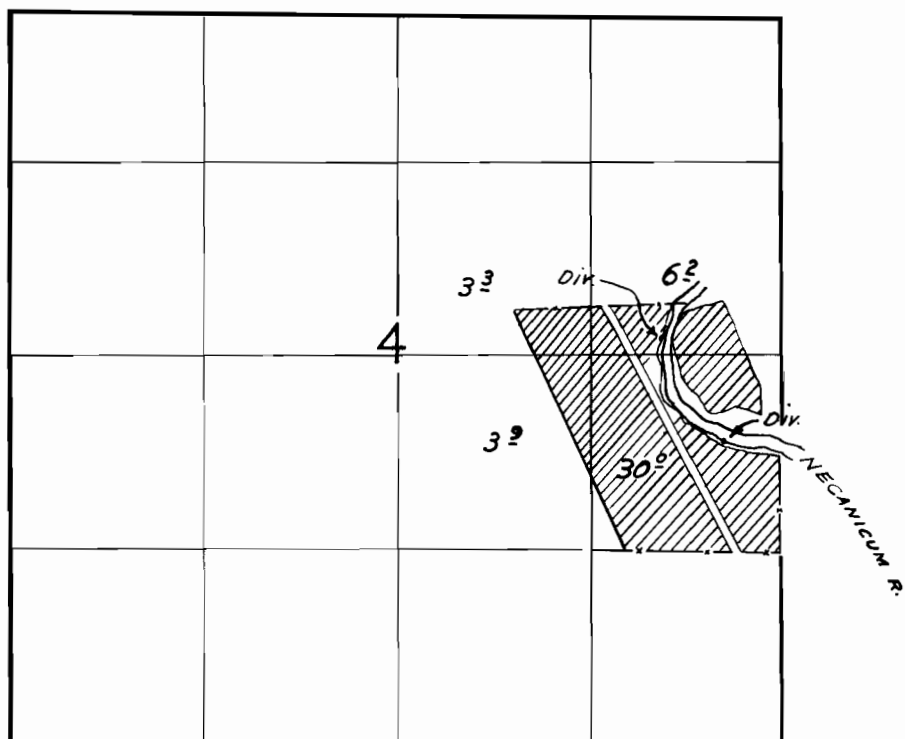

FINAL PROOF SURVEY
UNDER

Application No. 17435 Permit No. 13156
IN NAME OF

P. H. West

Surveyed Aug. 11, 1941, by Chester Cummings