


TOWNSHIP 9 S., RANGE 2 W.

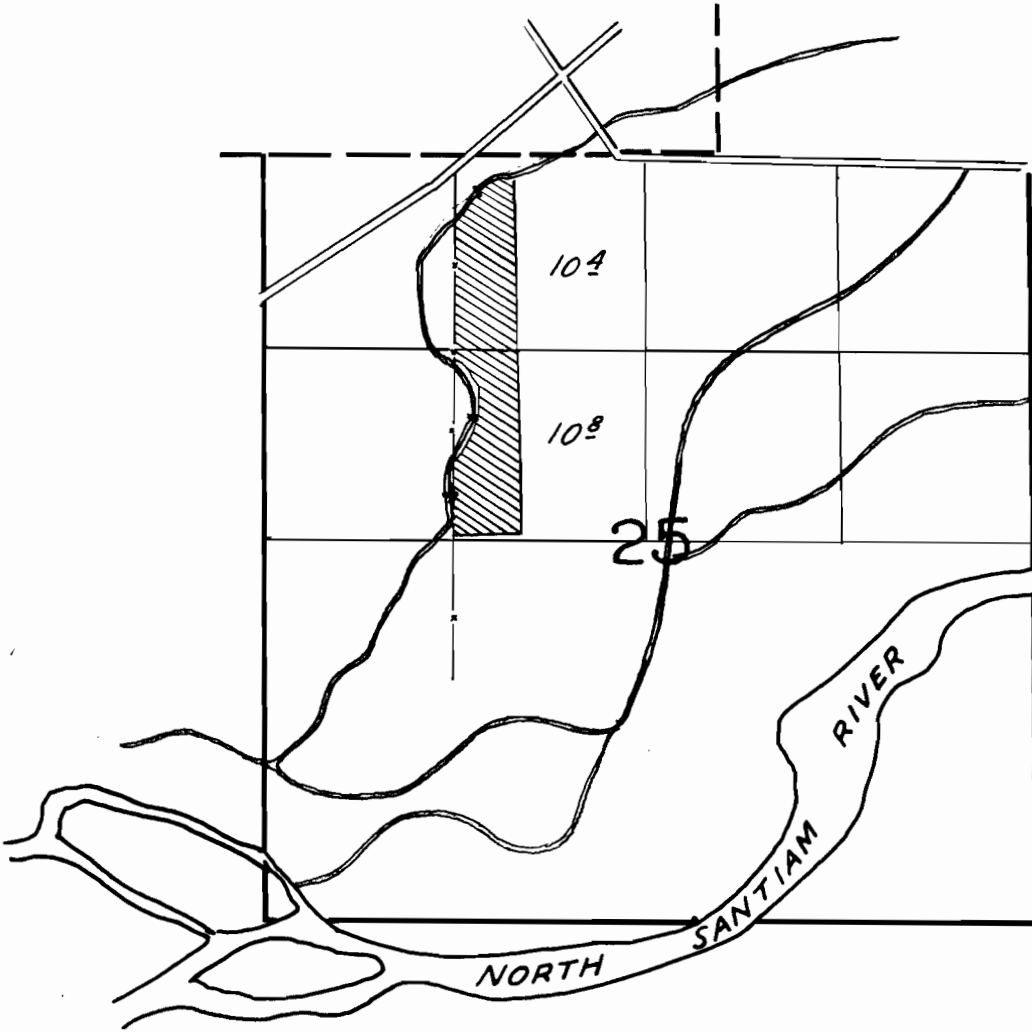

FINAL PROOF SURVEY

UNDER

Application No. 17493 Permit No. 13200

IN NAME OF

John H. Denny

Surveyed May 15, 1941, by [Signature]