


TOWNSHIP 3 N.. RANGE 2 W.

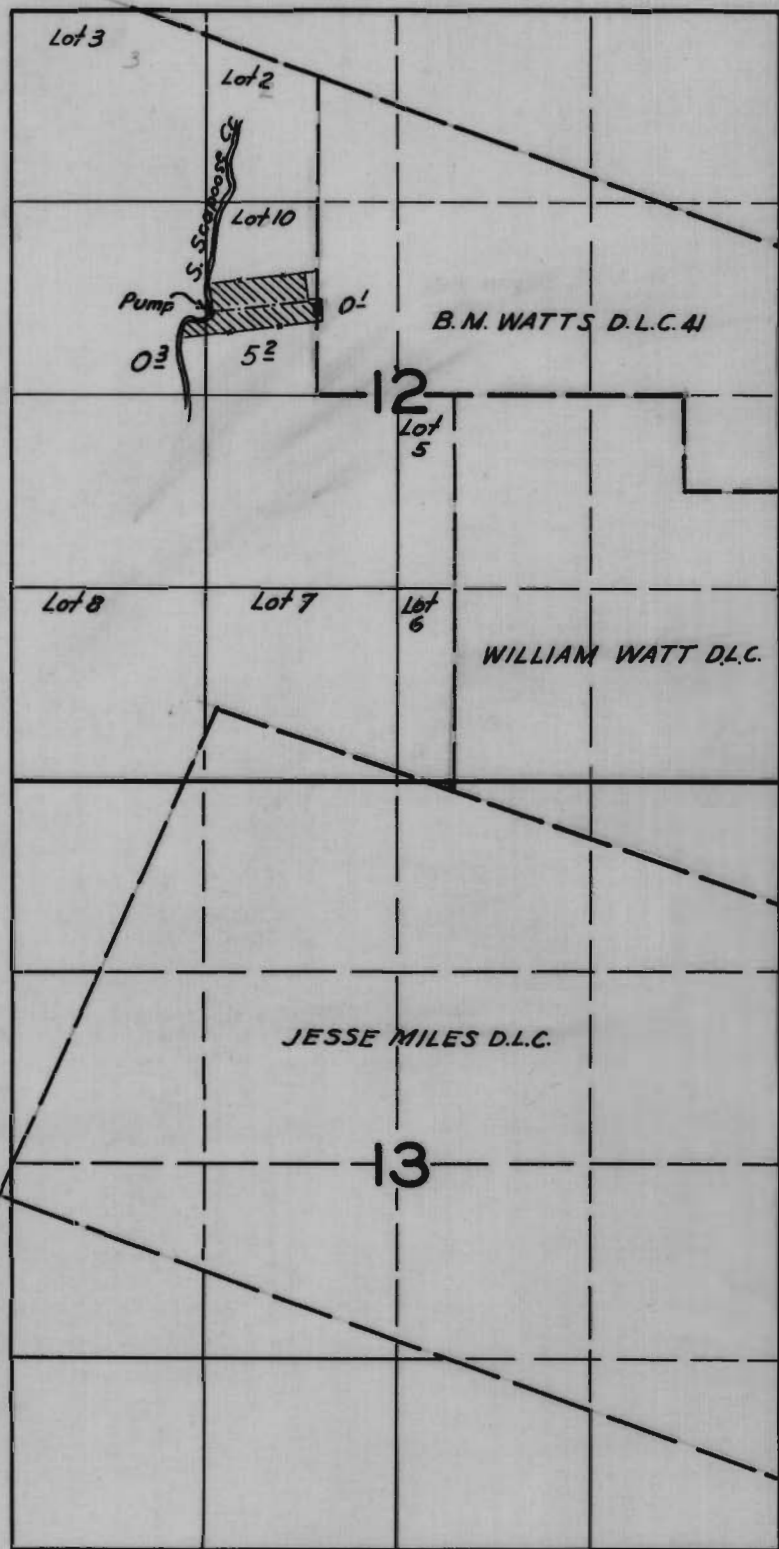

FINAL PROOF SURVEY UNDER

Application No. 17537 Permit No. 13243

IN NAME OF

C. E. Lambert

Surveyed Aug. 12, 1941, by Chester Cummings