


TOWNSHIP 4 N. RANGE 10 W. W.M.

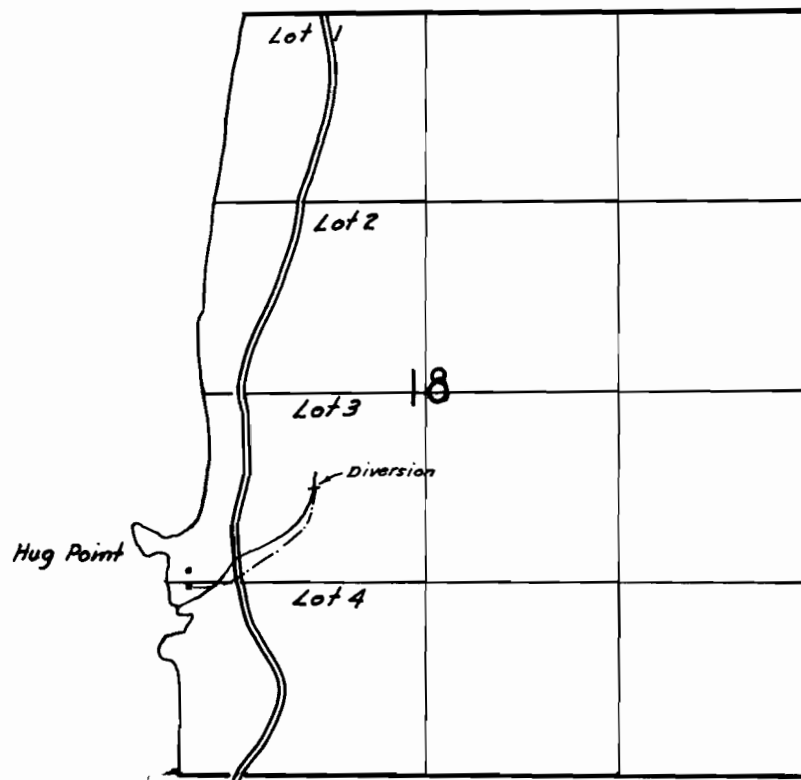

FINAL PROOF SURVEY
UNDER

Application No. 17574 Permit No. 13325

IN NAME OF

Rudolph Kissling

Surveyed Aug 11 1941, by Charles A. Summering