


TOWNSHIP 3 S., RANGE 2.W.

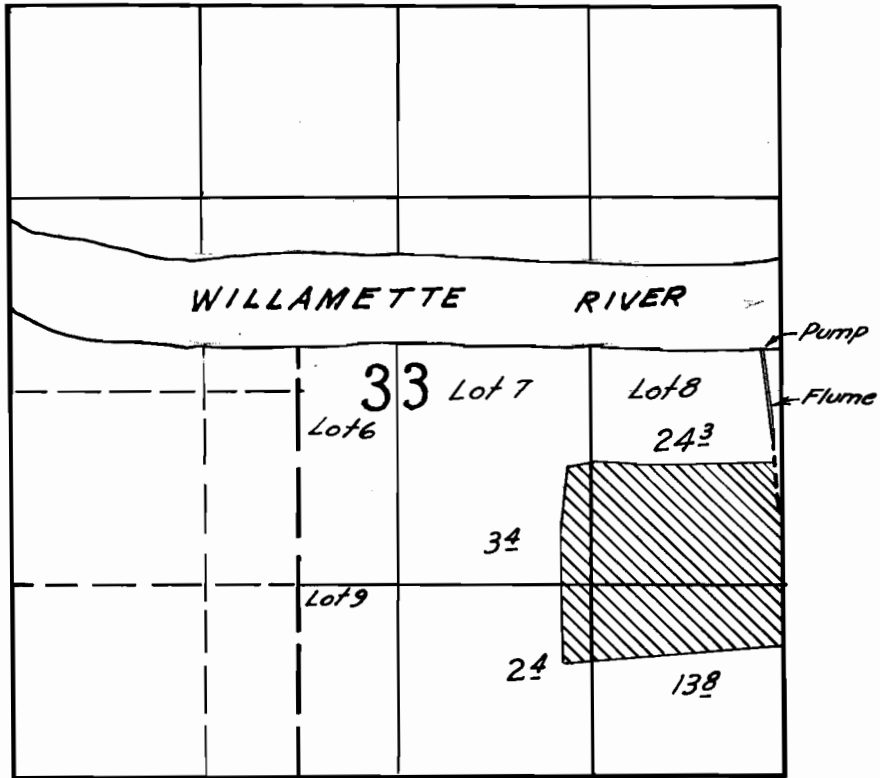

**FINAL PROOF SURVEY**  
UNDER

Application No. 17646 Permit No. 13342

IN NAME OF

Barbara Ann Austin

Surveyed May 7 1941, by C. Hummer