


SECTION 4

TOWNSHIP 7N, RANGE 4W W.M.

North

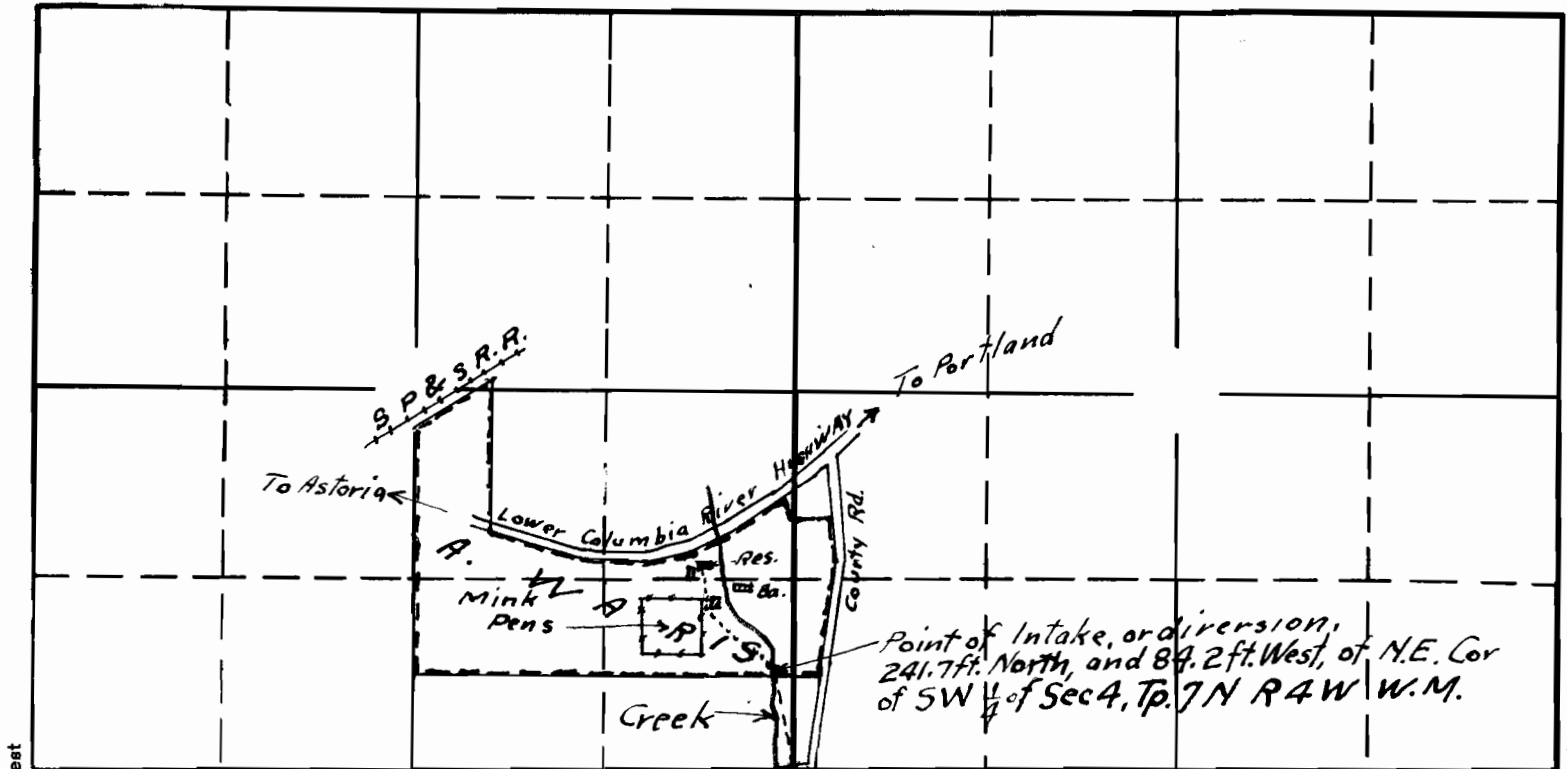

----- Pipe Line
 - - - - - Boundary of A. WARIS, property.

Certificate -

I, G. J. Poycky, of Clatskanie, Ore., hereby certify that this map was made from notes taken from an actual survey made by me on Oct 5 1938, and that it correctly represents the works shown thereon.

G. J. Poycky

G. J. Poycky

MAP

Showing Water Appropriation
 OF
 A. WARIS
 Clatskanie, Oregon.
 Scale: 1 in = 660 ft.

South

17596 T.
 17596
 APPLICATION No. 17596
 PERMIT No. 13410