


TOWNSHIP 13S., RANGE 11W.

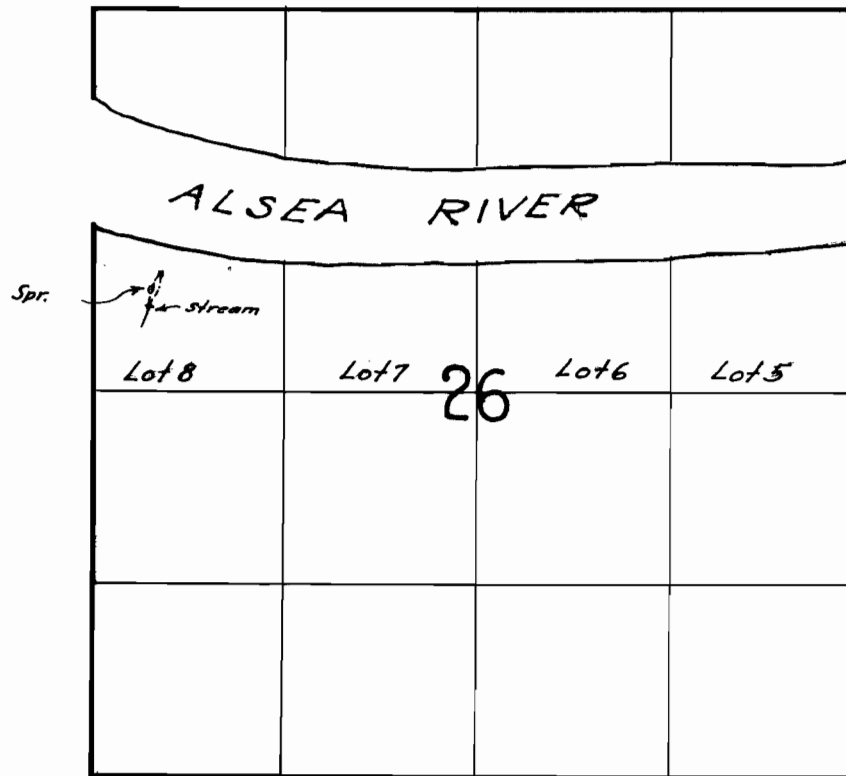

**FINAL PROOF SURVEY**  
UNDER

Application No. 17768 Permit No. 13456

IN NAME OF

Alfred V. Dalphy

Surveyed Aug 7 1941, by B. L. Cunningham