


TOWNSHIP 5 S., RANGE 1 E.

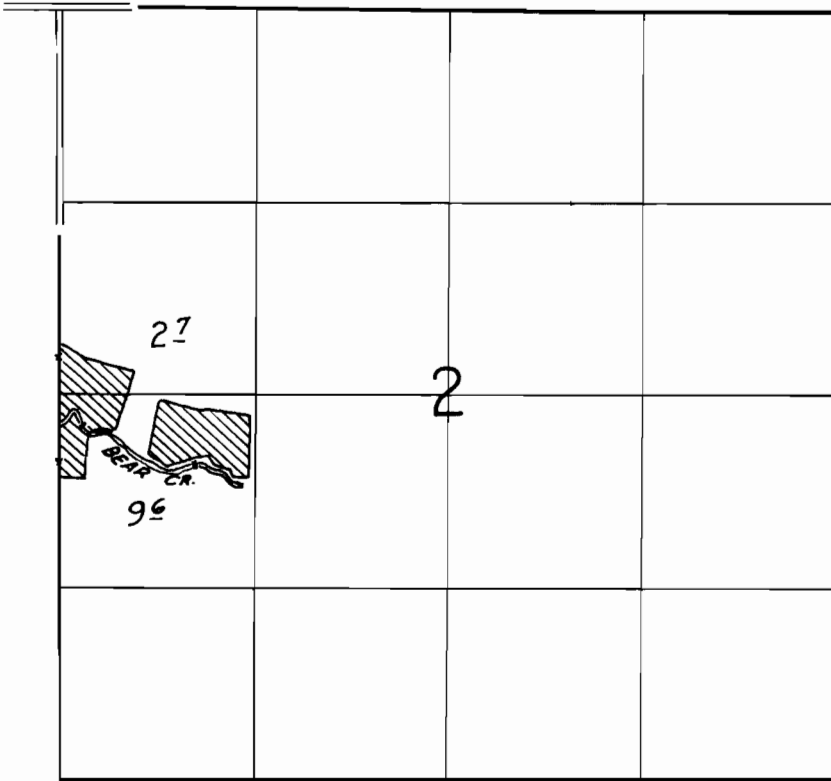

FINAL PROOF SURVEY  
UNDER

Application No. 17794 Permit No. 13473

IN NAME OF

W.W. Dreher

Surveyed May 27 1941, by Ed Cummings