


TOWNSHIP 6 S., RANGE 46 E.

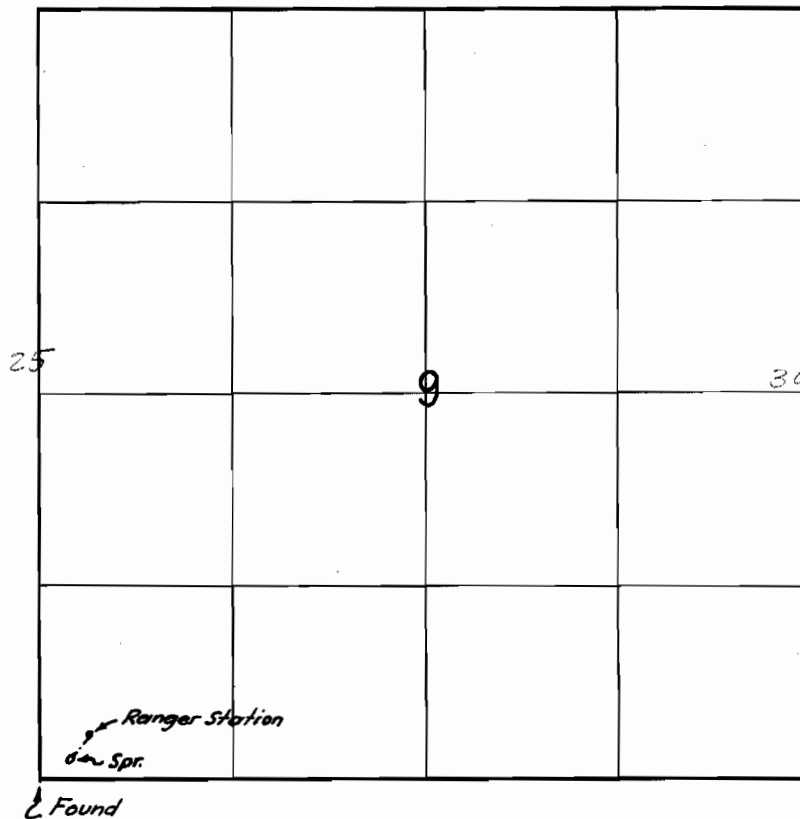

36

37

FINAL PROOF SURVEY

UNDER

Application No. 7918 Permit No. 3604

IN NAME OF

U. S. Forest Service

Surveyed July 29 1941, by Chas. E. Cummings