


TOWNSHIP 4S., RANGE 3W

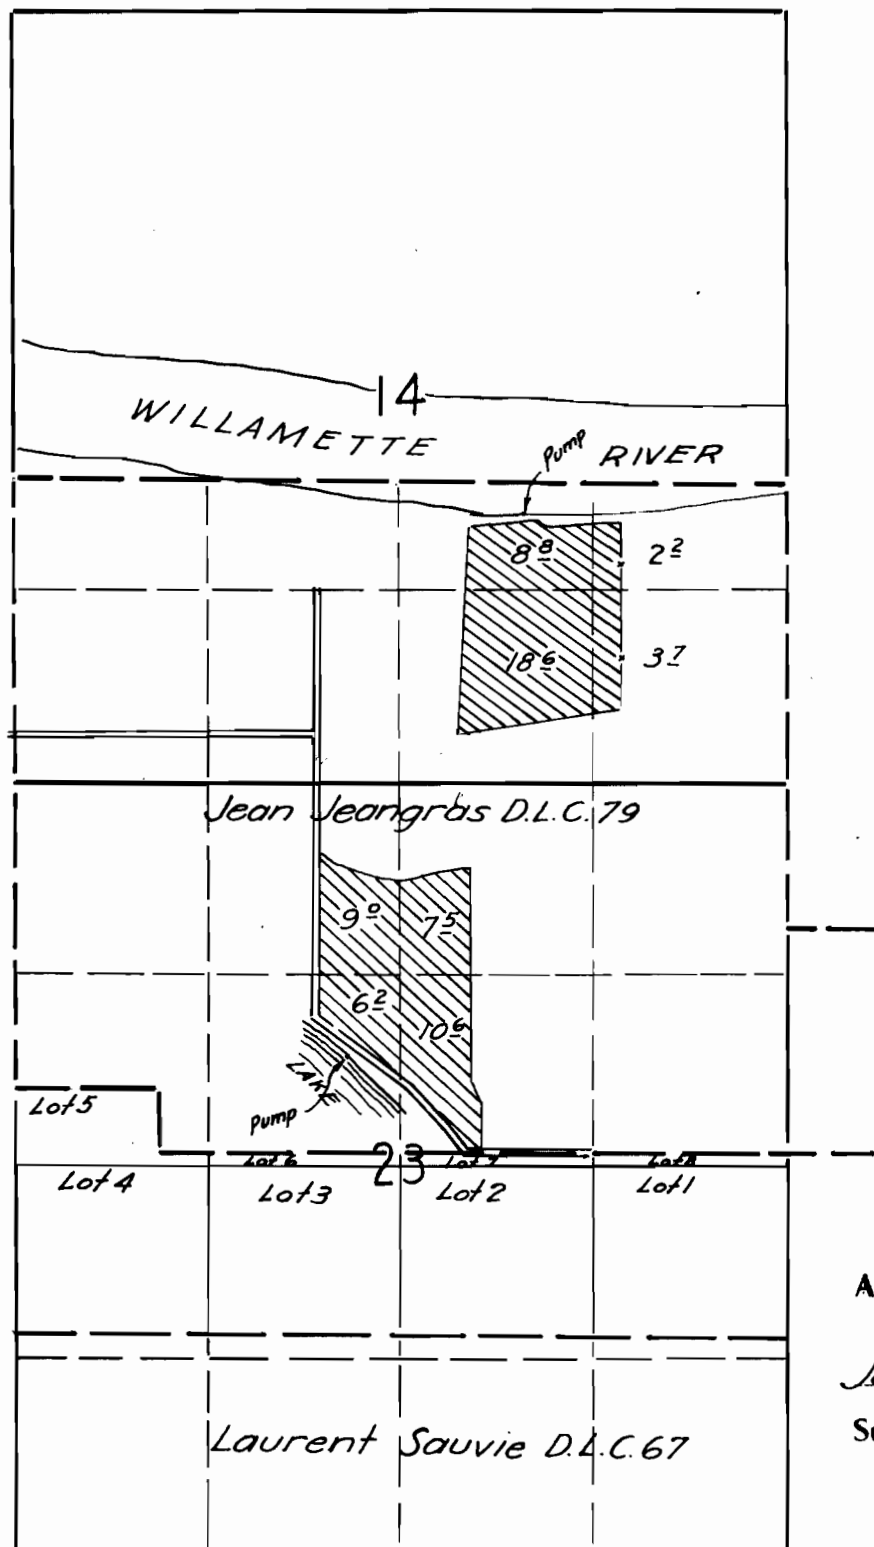

FINAL PROOF SURVEY
UNDER

Application No. 17936 Permit No. 13618

IN NAME OF

John M. Rasmussen

Surveyed May 8, 1941, by L. Rasmussen