


TOWNSHIP 4 S., RANGE 1 E.

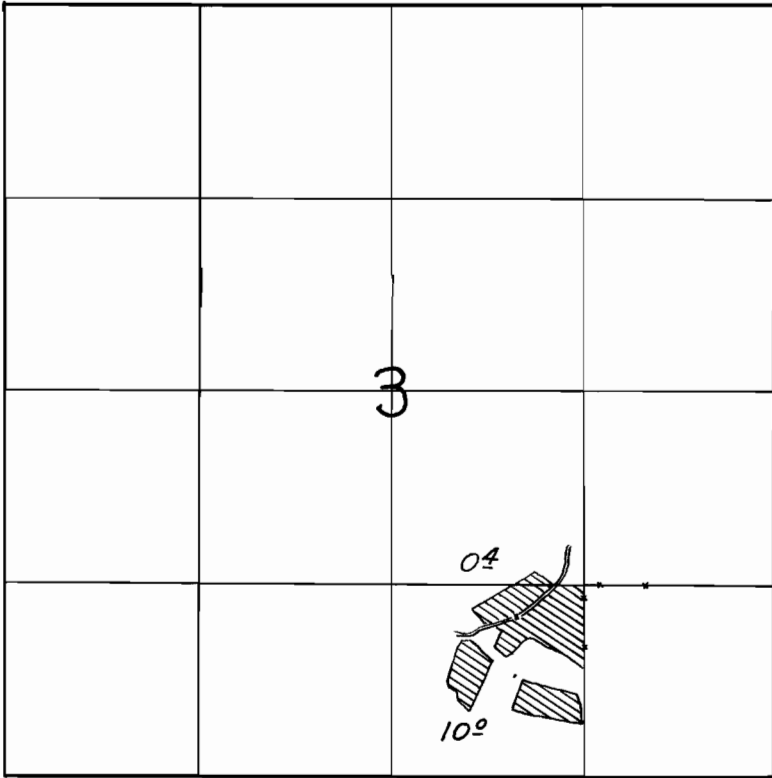

FINAL PROOF SURVEY

UNDER

Application No. 17956 Permit No. 13635

IN NAME OF

Matt Faist

Surveyed May 27 1941, by Cliff Cummings