


TOWNSHIP 9 S. RANGE 6 W.

Marion

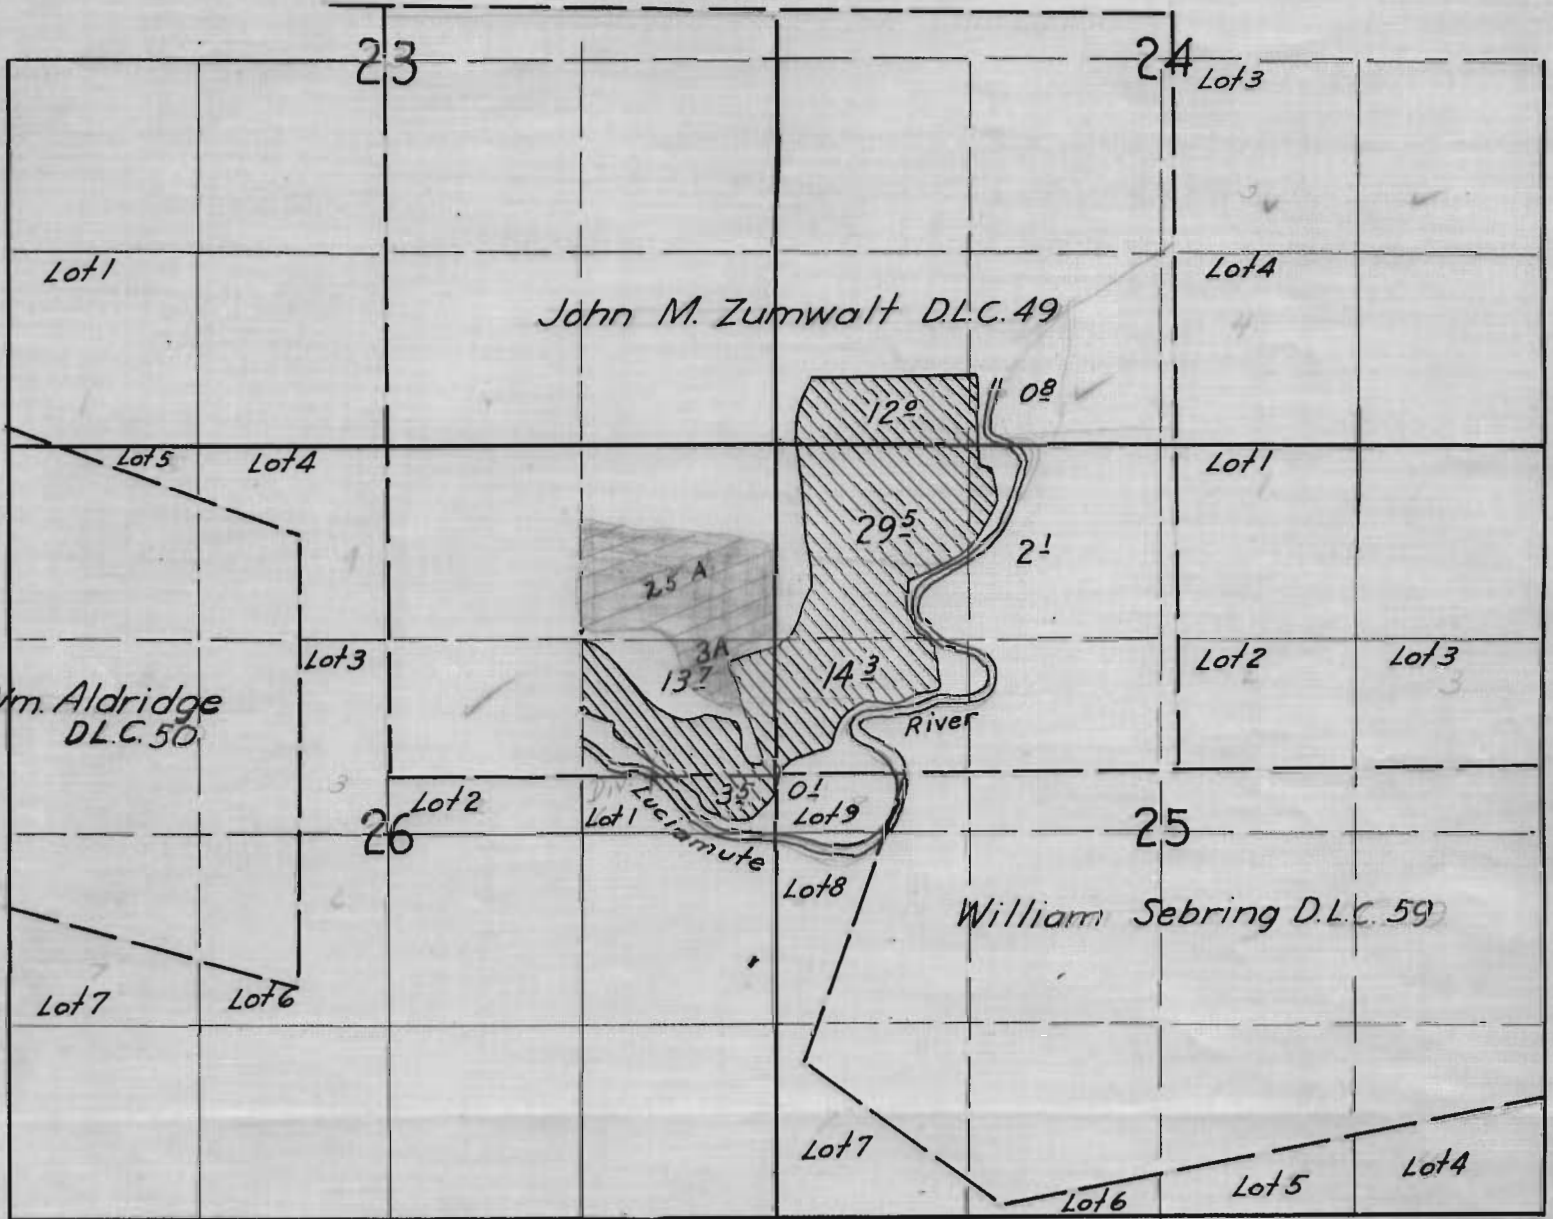

FINAL PROOF SURVEY
UNDER

Application No. 17997 Permit No. 13670

IN NAME OF

M. E. Branch

Surveyed May 12 1941, by E. Humming

Application No. 25602
Permit No. 20089

Application No. 22935
Permit No. 18189