


TOWNSHIP 7 S., RANGE 3 W.

*Copied from  
S-17970*

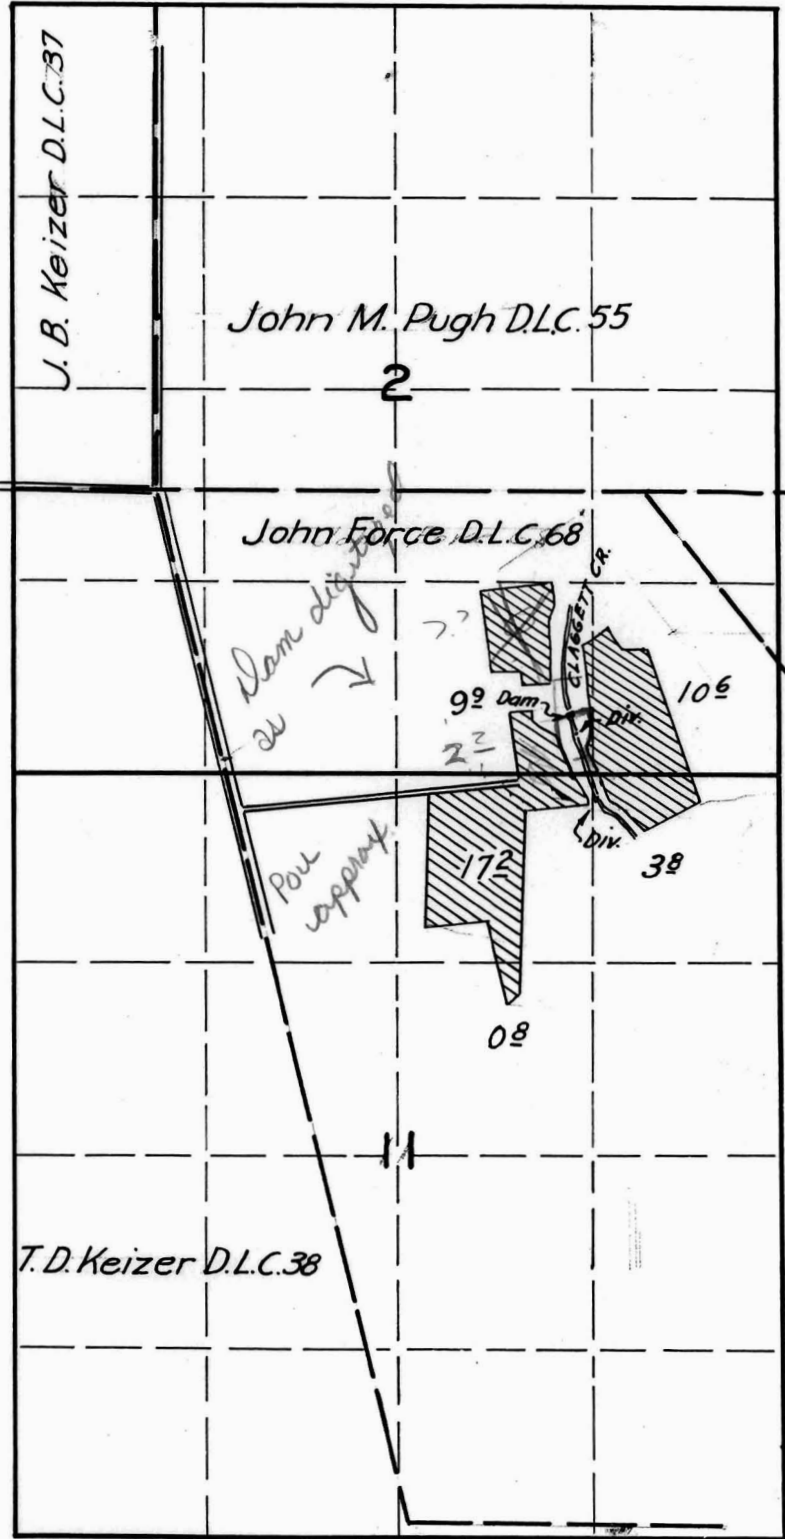

**FINAL PROOF SURVEY**

UNDER

Application No. R-17969 Permit No. R-730  
S-17970 13702

IN NAME OF

David Saucy

Surveyed May 10 1941, by E. L. Summings