


TOWNSHIP 5 S., RANGE 7 W.

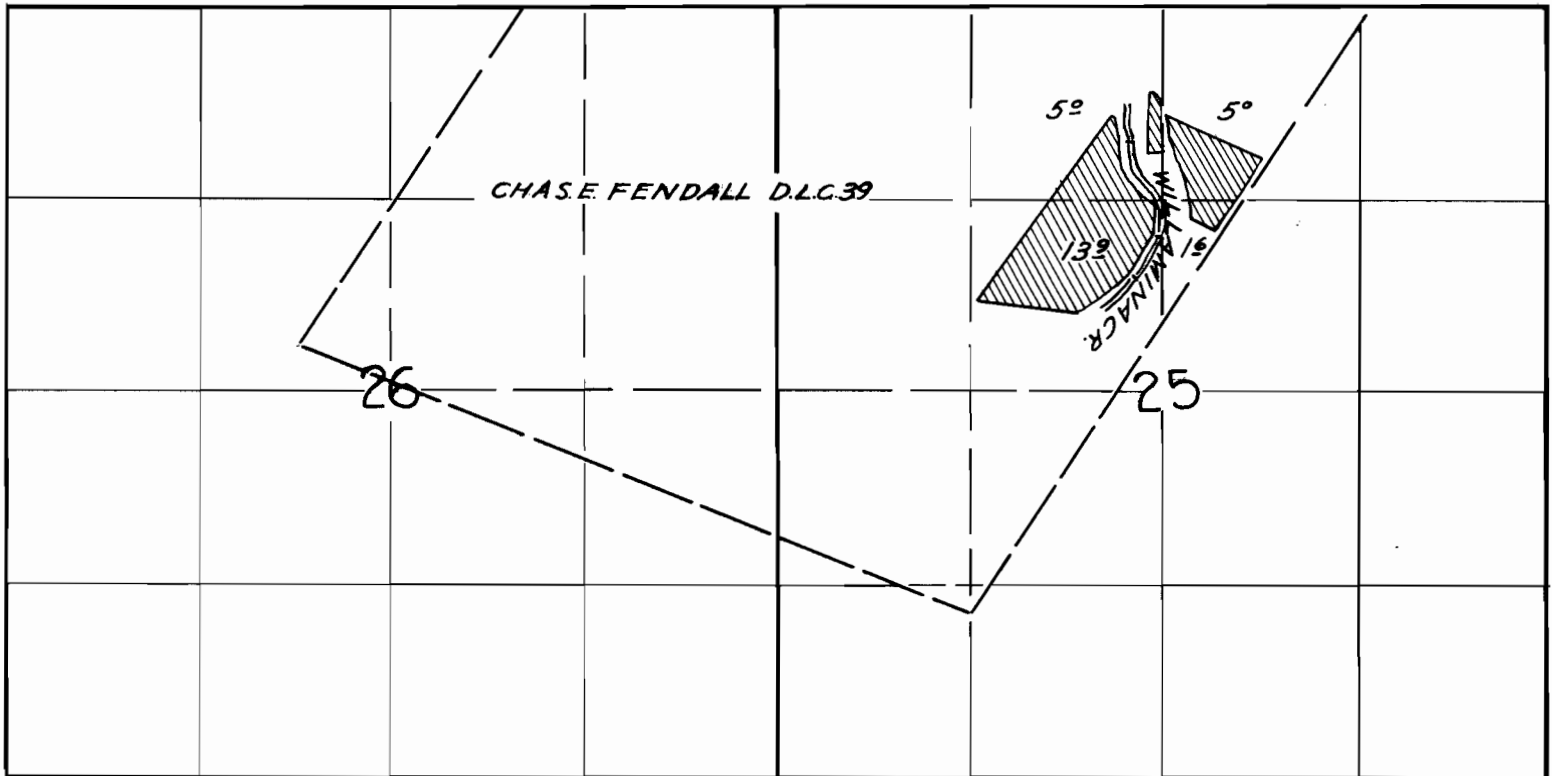

FINAL PROOF SURVEY

UNDER

Application No. 17996 Permit No. 13863

IN NAME OF

Kate Johnston

Surveyed Apr 28 1941, by [Signature]