


TOWNSHIP 7 S. RANGE 1 W.

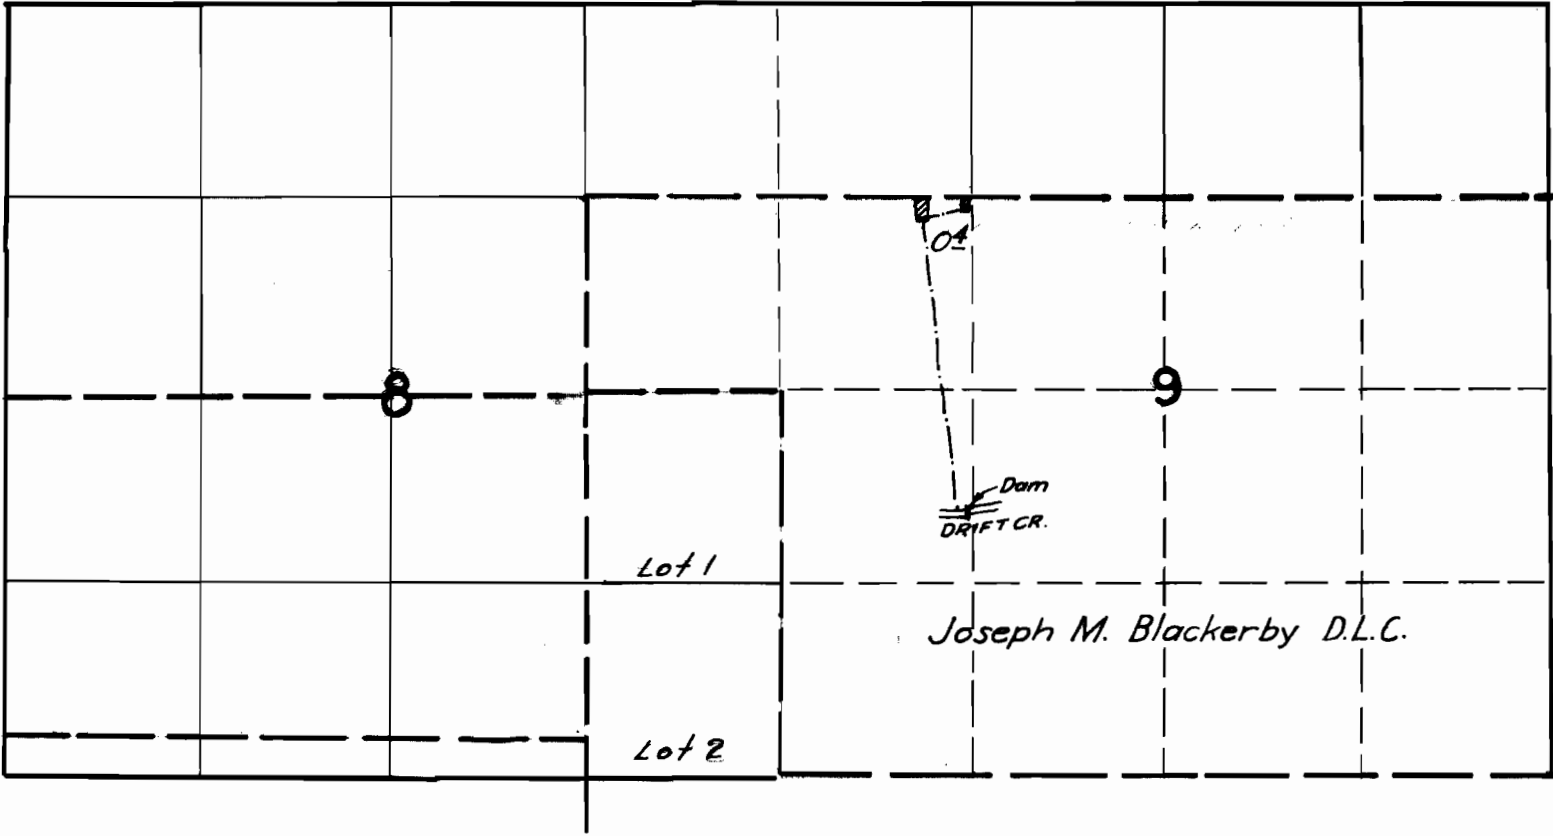

FINAL PROOF SURVEY

UNDER

Application No. 18068 Permit No. 13734

IN NAME OF

Walter Von Flue

Surveyed May 9, 1941, by Chestnut Cunningham