


TOWNSHIP 4 S. RANGE 2 E.

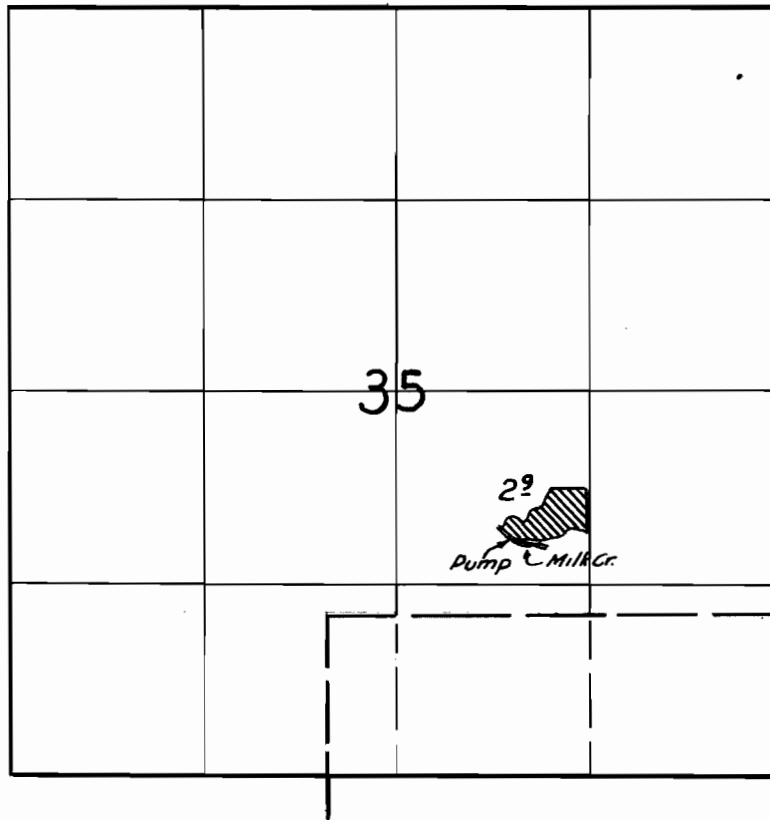

FINAL PROOF SURVEY
UNDER

Application No. 18194 Permit No. 13820

IN NAME OF

Matt Anderson

Surveyed May 24 1941, by Ed Summers