


TOWNSHIP 4 S., RANGE 3 W.

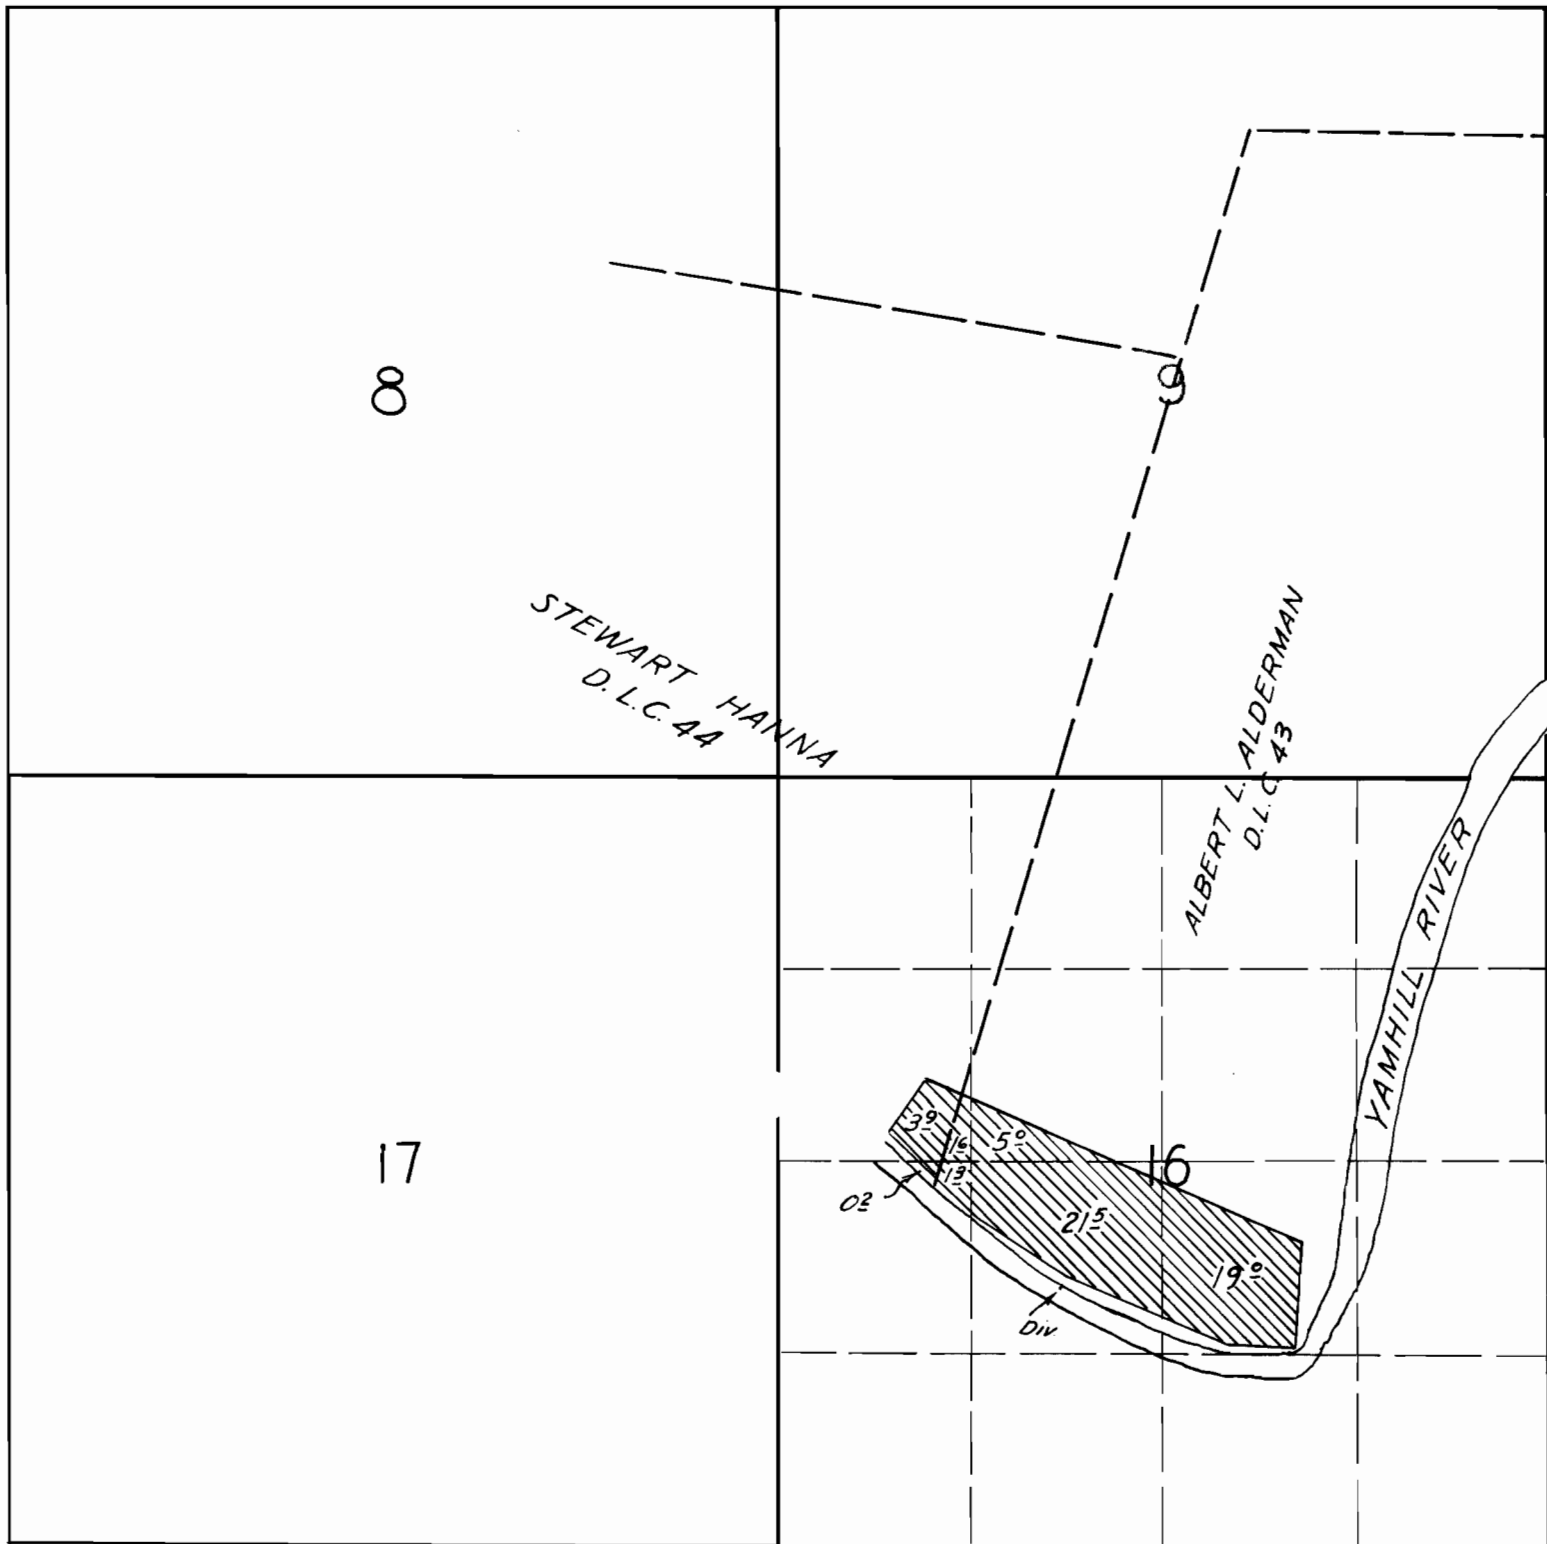

**FINAL PROOF SURVEY**

UNDER


Application No. 18217 Permit No. 13836

IN NAME OF

*Eva Alderman Powell*

Surveyed Apr. 25 1941, by *Chas. H. ...*

R. 3 W. W. M.

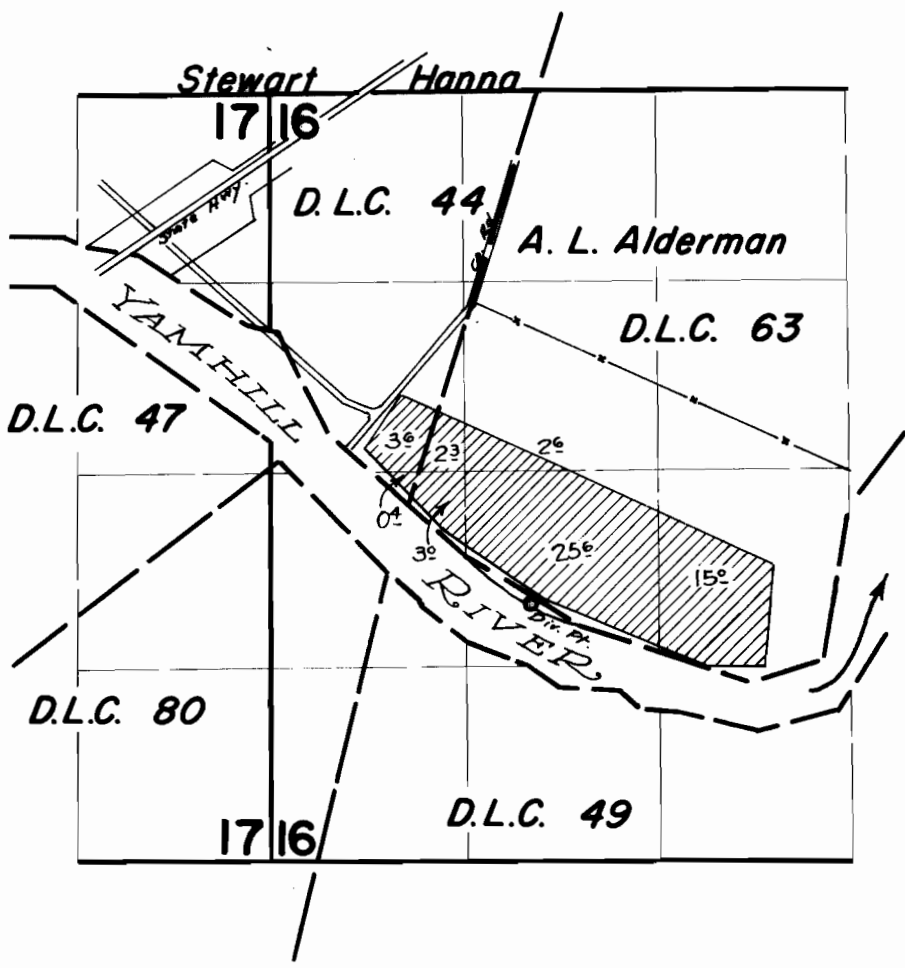

**FINAL PROOF SURVEY**  
UNDER

Application No. 18217..... Permit No. 13836....  
IN NAME OF

U. S. ALDERMAN

Surveyed April 25, 1941..., by C. A. Cummings