TOWNSHIP 2 S., RANGE 5 W.

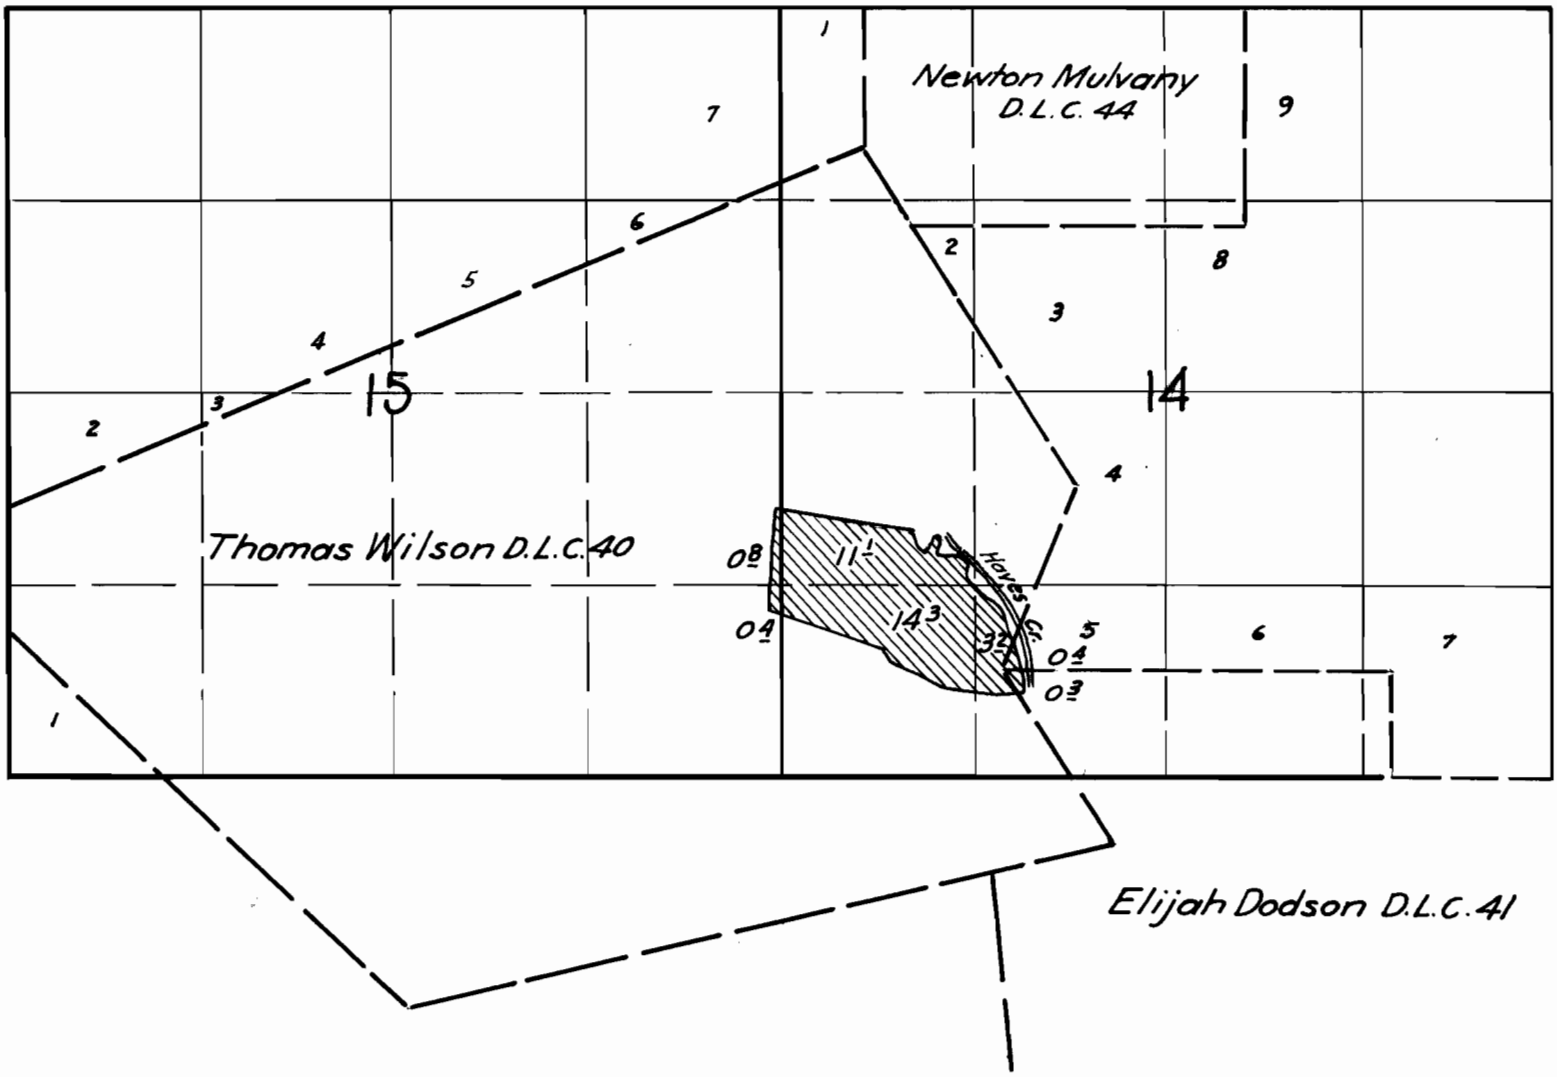

FINAL PROOF SURVEY

UNDER

Application No. 18153 **Permit No.** 13875

IN NAME OF

Gertrude Greenhoot Estate

Surveyed Apr. 29 **19**41, **by** L. L. Cummings