


TOWNSHIP 8 S., RANGE 34E.

Per 13900
14241

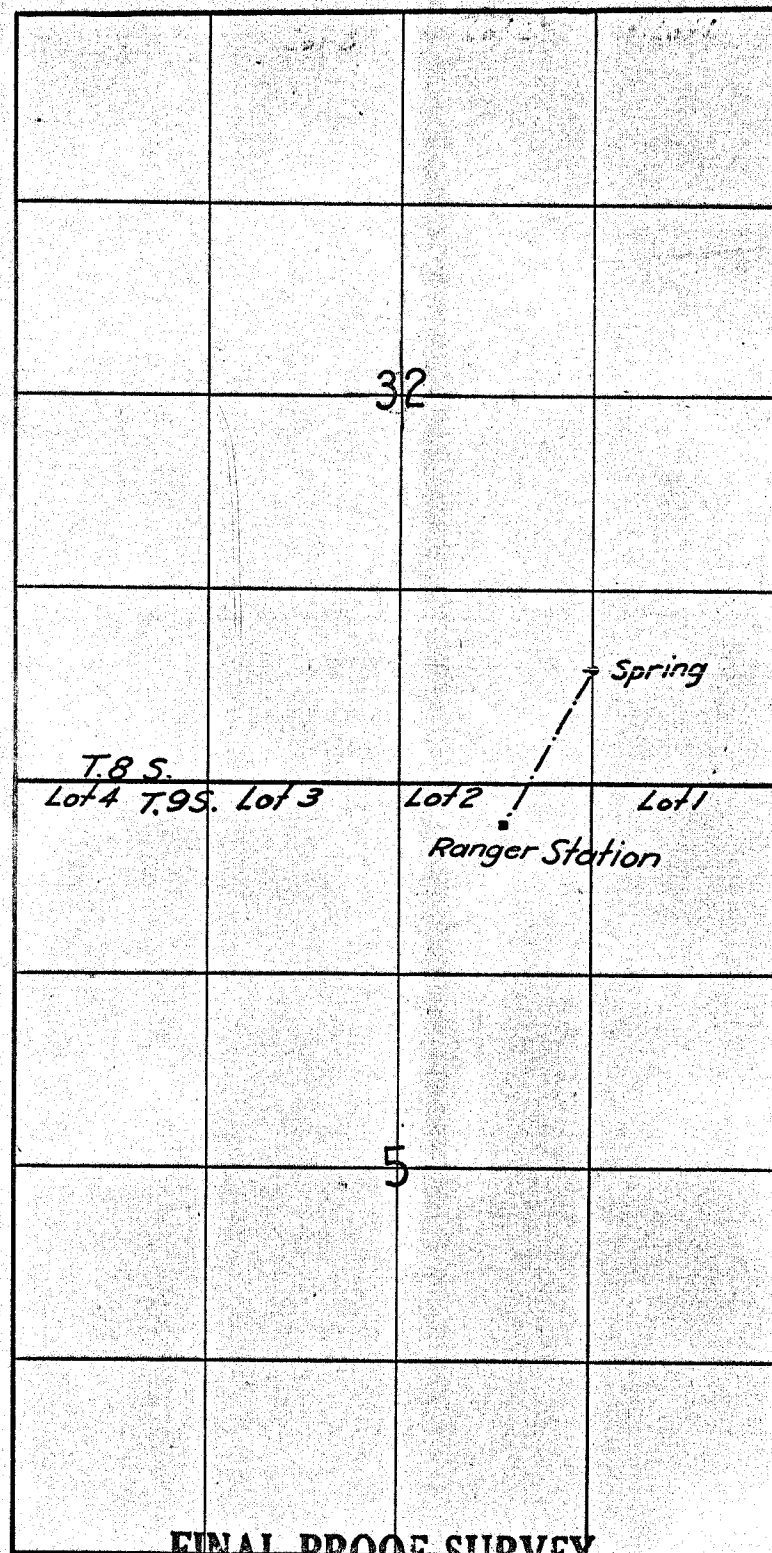

FINAL PROOF SURVEY

UNDER

Application No. 18239 Permit No. 13900

IN NAME OF

Whitman National Forest

Surveyed July 30, 1941, by Charles C. Gunning