


TOWNSHIP 11S., RANGE 11W. W. M.

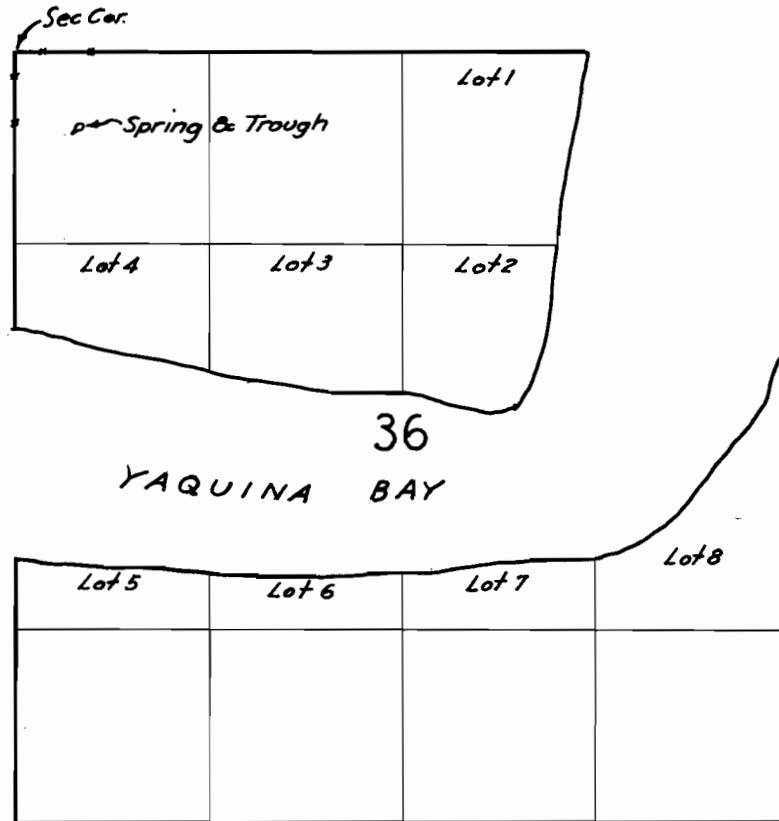

FINAL PROOF SURVEY

UNDER

Application No. 18296 Permit No. 13942

IN NAME OF

Ada D. Hills

Surveyed Aug. 7, 1941, by Ed. Hummings