


TOWNSHIP 12 S., RANGE 8 W. W. M.

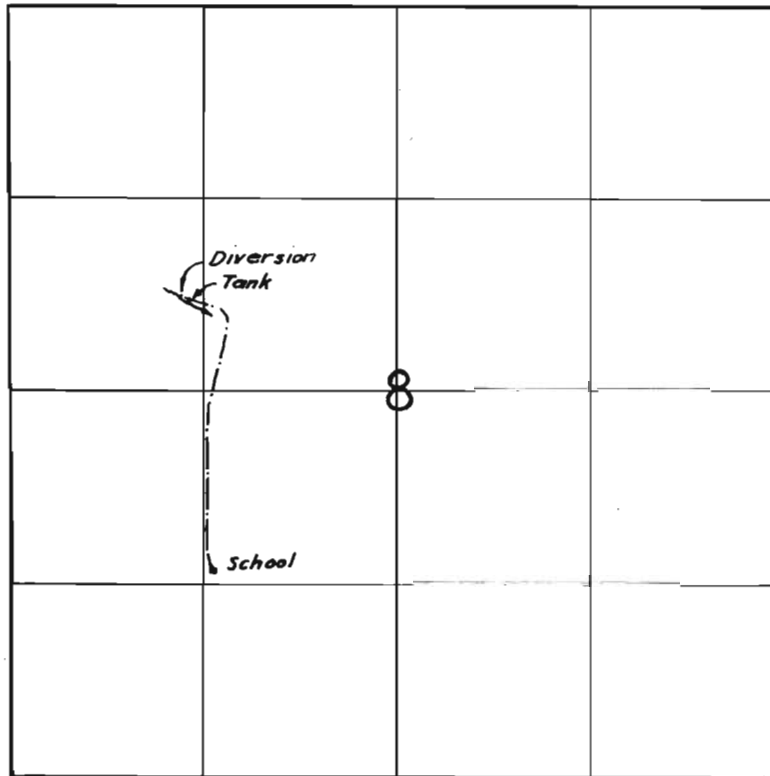

FINAL PROOF SURVEY

UNDER

Application No. 18326 Permit No. 13960

IN NAME OF

Lincoln County School Board

Surveyed Aug. 8, 1941, by W. M. Cummings