


TOWNSHIP 14 S., RANGE 19 E.

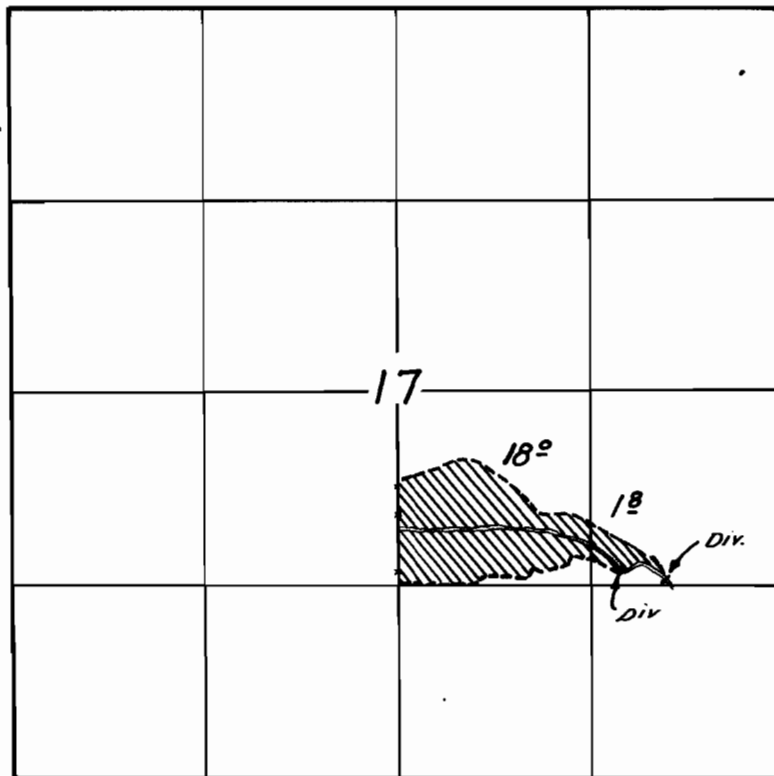

FINAL PROOF SURVEY
UNDER

Application No. 18362 Permit No. 13985

IN NAME OF

Bernice Elkins

Surveyed July 15 1941, by Chester Cumming