


FINAL PROOF SURVEY
UNDER

Application No. 18314 Permit No. 14008

IN NAME OF

OM. & M.C. Thompson

Surveyed May 21 1941, by Edg

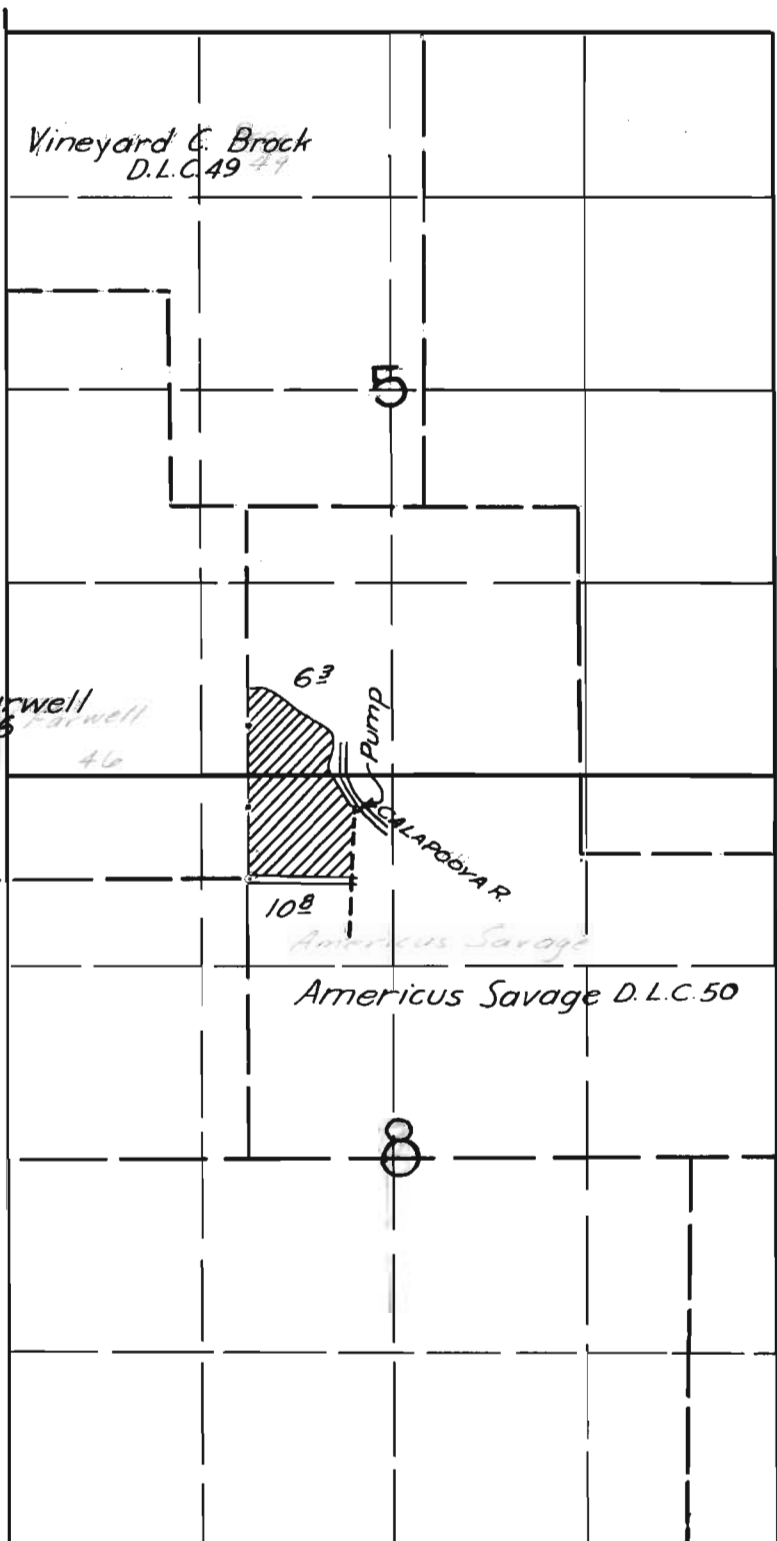

FINAL PROOF SURVEY

UNDER

Application No. 18314 Permit No. 14008

IN NAME OF

O.M. & M.C. Thompson

Surveyed May 21, 1941, by Blumming