


TOWNSHIP 10 S. RANGE 33 E.

Per. 14039
14253

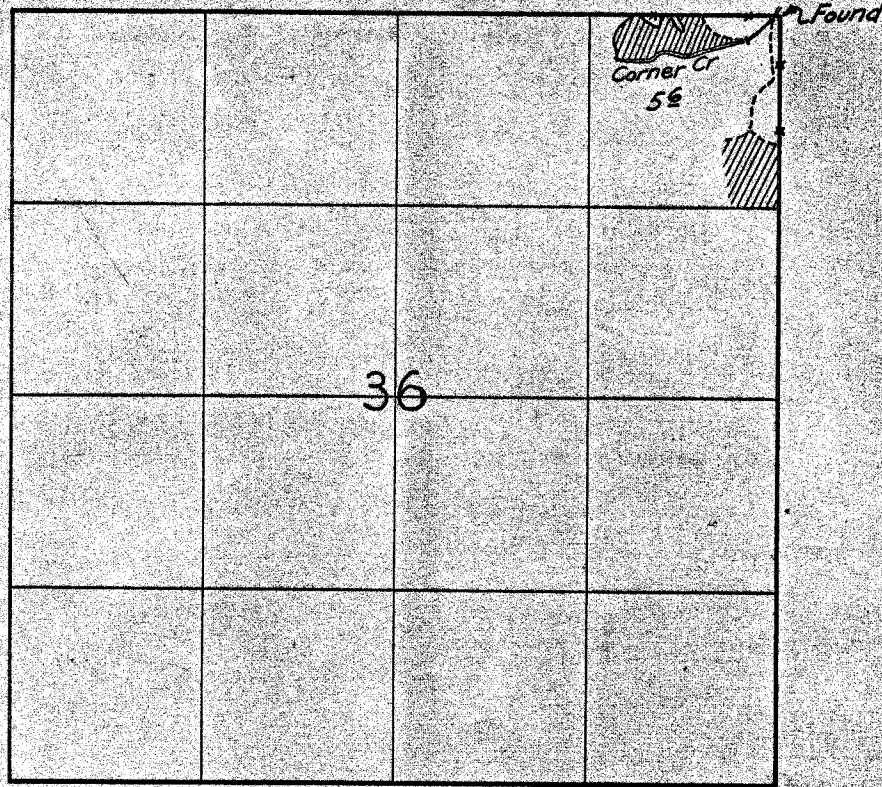

FINAL PROOF SURVEY
UNDER

Application No. 18402 Permit No. 14039

IN NAME OF

T. Gail DeWitt

Surveyed July 31, 1941, by Charles Cunningham