


TOWNSHIP 13 S RANGE 12 W.

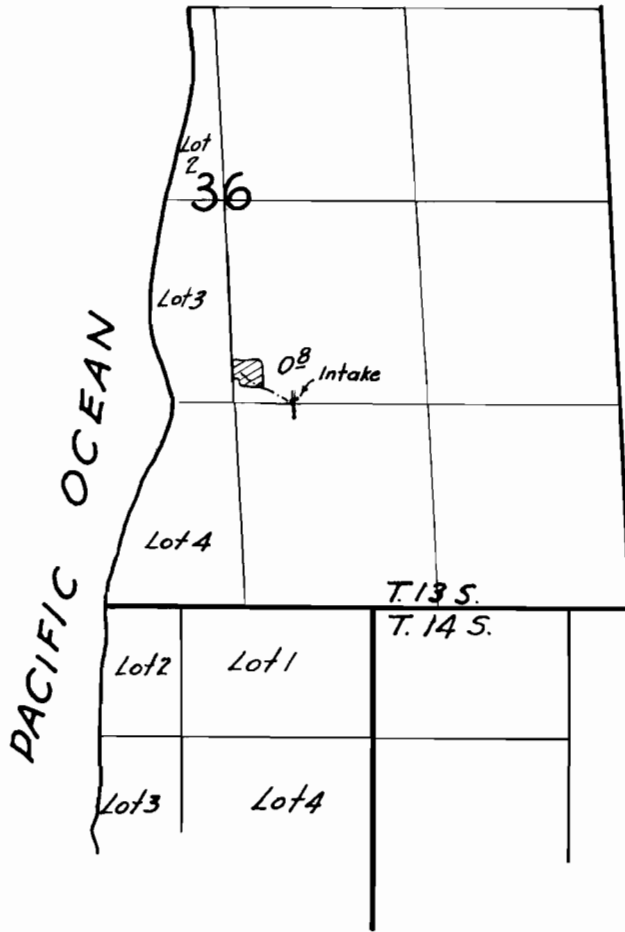

**FINAL PROOF SURVEY**

UNDER

Application No. 18408 Permit No. 14045

IN NAME OF

H. A. Matheson

Surveyed Aug 7 1941, by B. Humming