FINAL PROOF SURVEY

UNDER

Application No. 18456 Permit No. 14091

IN NAME OF

R. E. Williams + L. H. Thacker
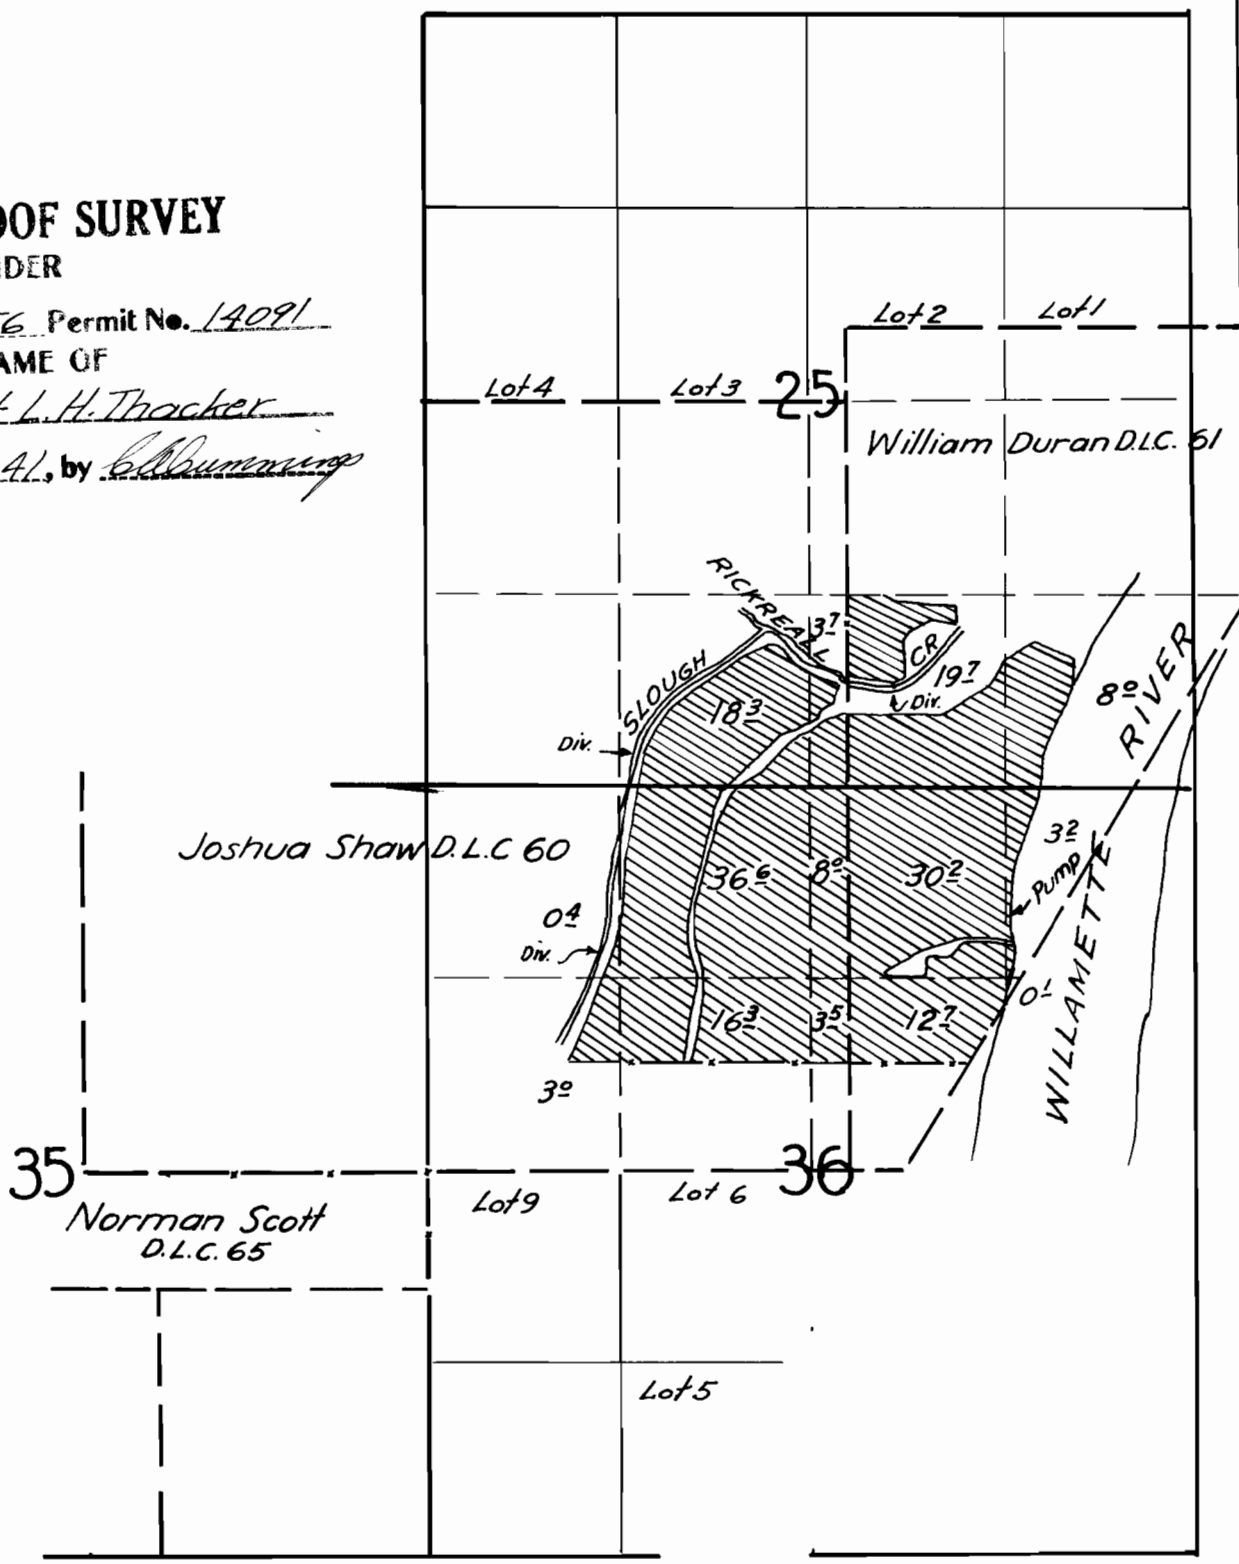
Surveyed May 13 1941, by C. A. Bunnings