


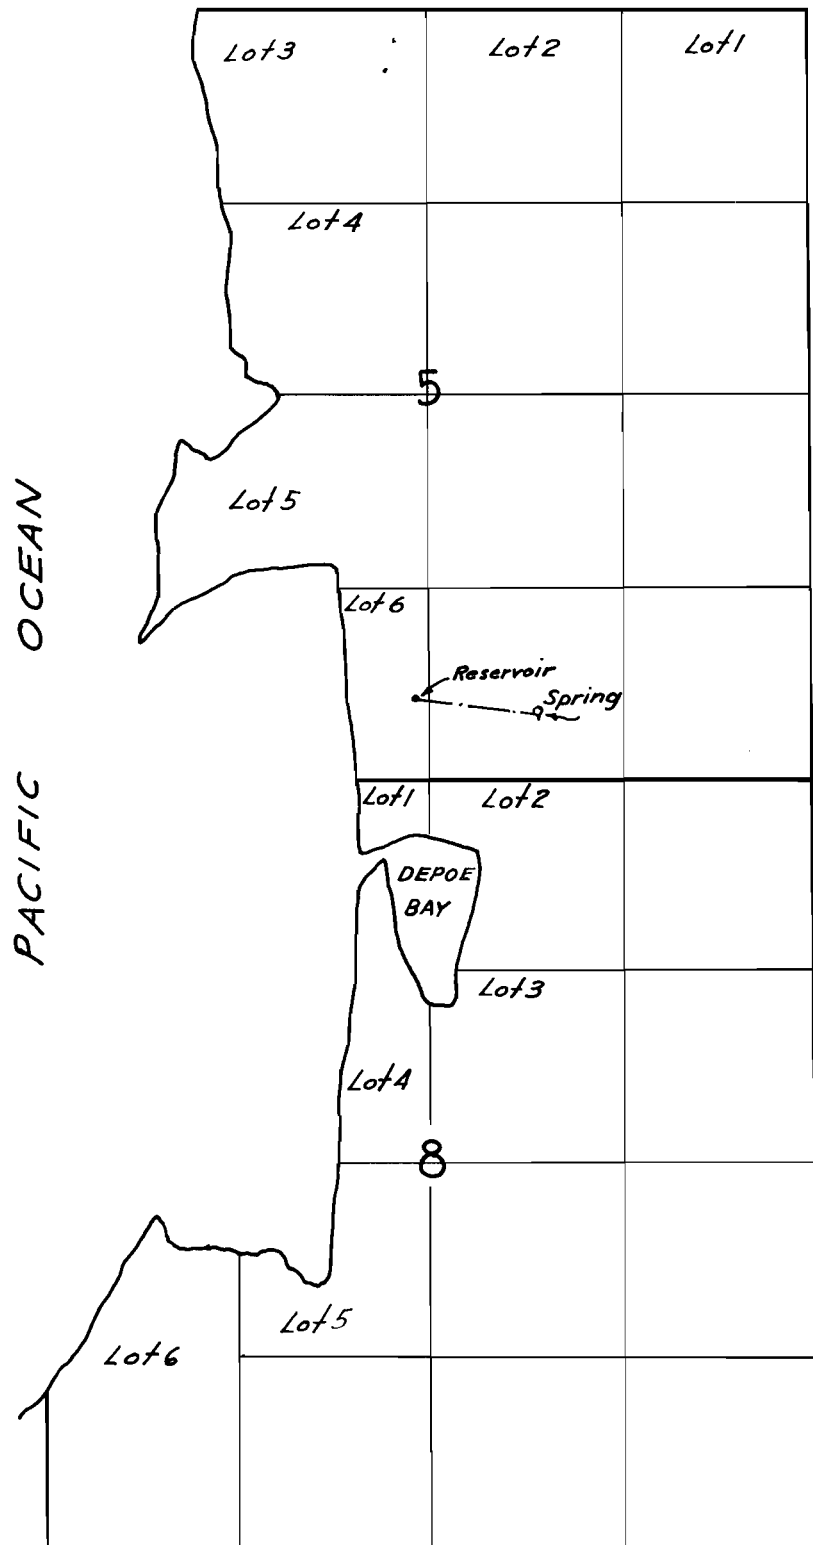

FINAL PROOF SURVEY
UNDER

Application No. 18454 Permit No. 14112

IN NAME OF

De Poe Bay Development Co.

Surveyed Aug. 8, 1941, by Chas. C. Cummings