


TOWNSHIP 9 S., RANGE 9 W. W. M.

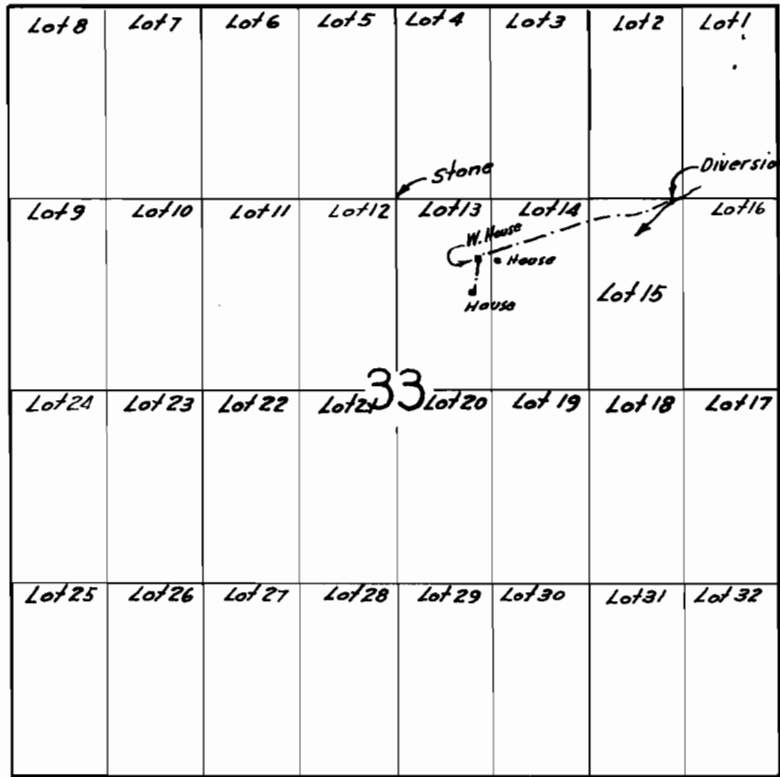

**FINAL PROOF SURVEY**

UNDER

Application No. 18514 Permit No. 14121

IN NAME OF

V. L. Gibson

Surveyed Aug. 8, 1941, by Ed. Cunningham