


TOWNSHIP 16 S. RANGE 20 E.

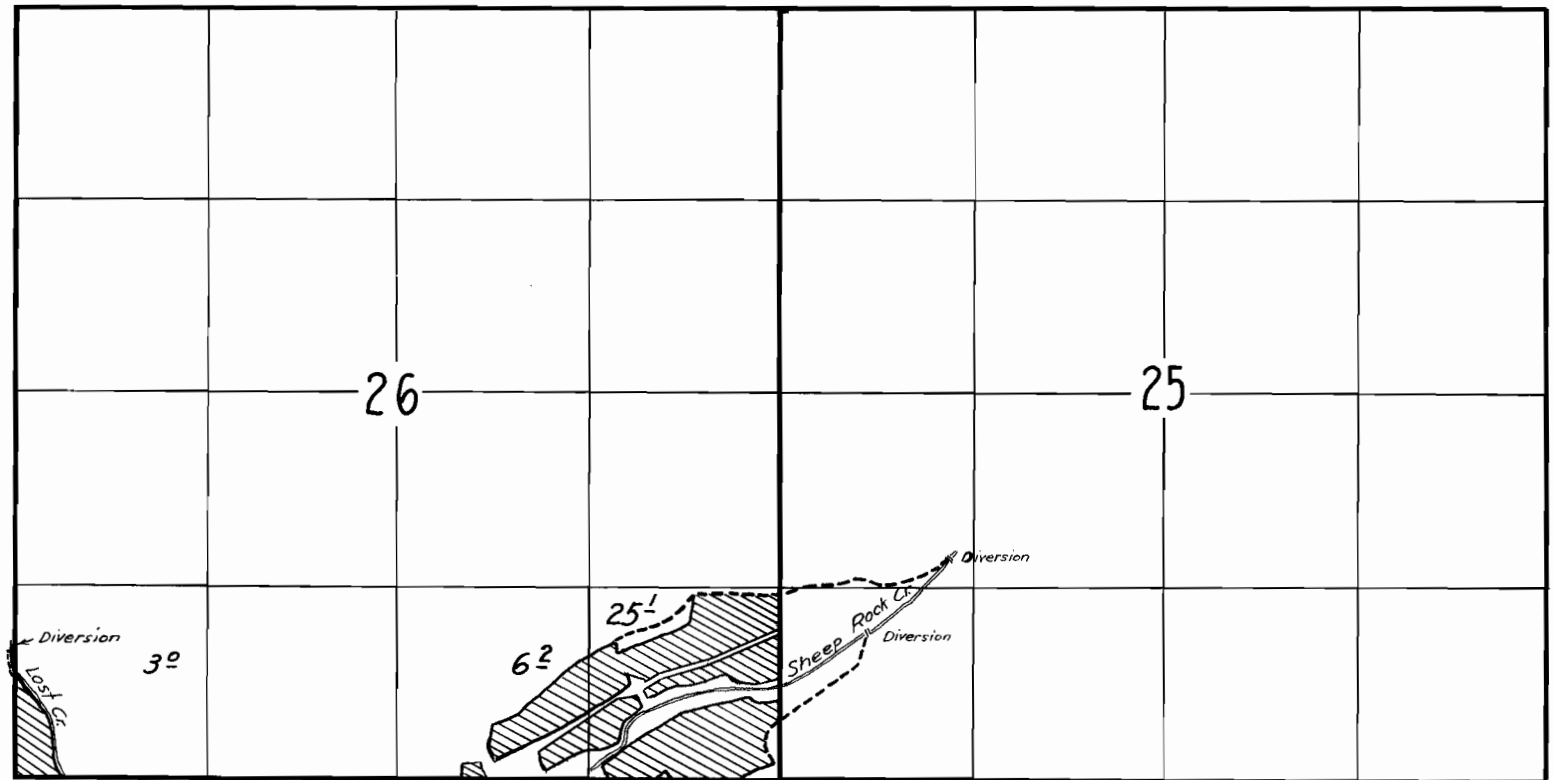

FINAL PROOF SURVEY
UNDER

Application No. 18515 Permit No. 14166

IN NAME OF

Arnold Nydegger

Surveyed July 15, 1941, by Ed Bunning