


TOWNSHIP 7 S., RANGE 2 E.

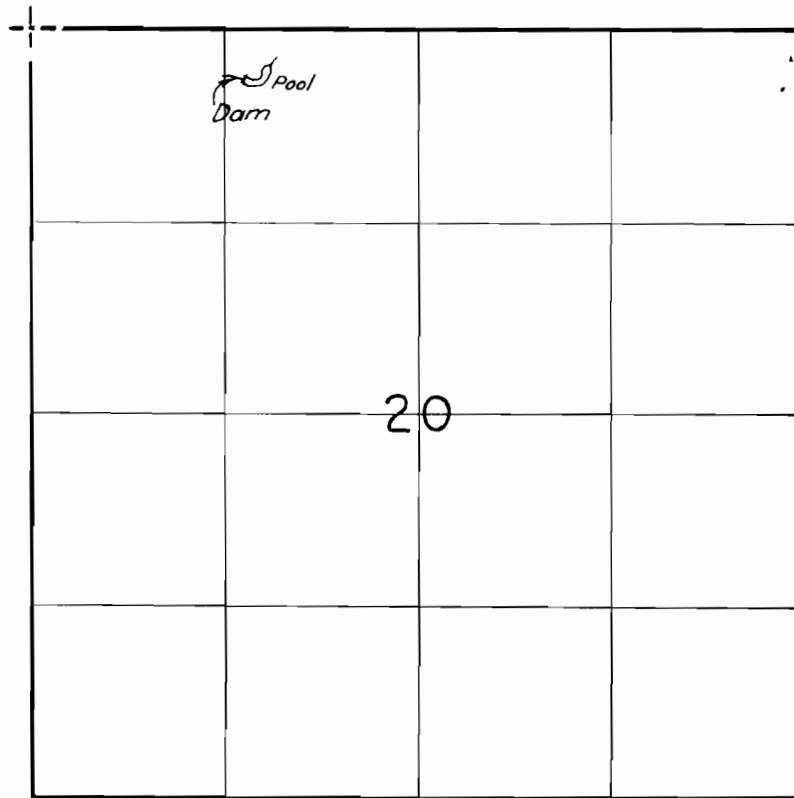

FINAL PROOF SURVEY

UNDER

Application No. 18527 Permit No. 14212

IN NAME OF

Abiqua City Club

Surveyed May 22 1941, by L. L. Humming