


TOWNSHIP 28 S. RANGE 34 E.

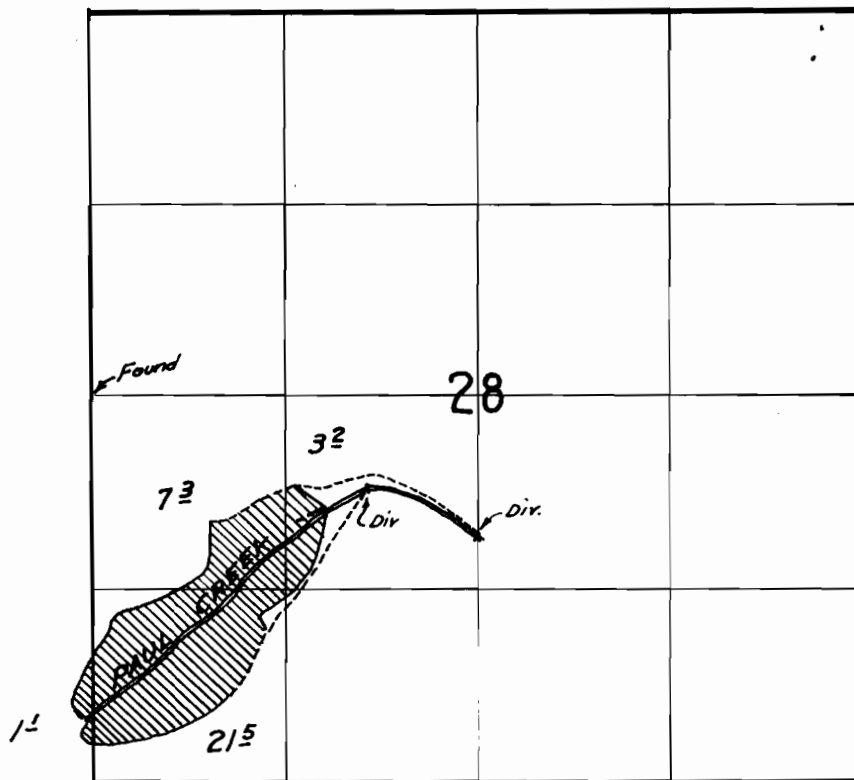

FINAL PROOF SURVEY
UNDER

Application No. 18634 Permit No. 14269

IN NAME OF

Gordon Mc Williams

Surveyed July 23, 1941, by Cummings