


TOWNSHIP 4 S., RANGE 8 W. W. M.

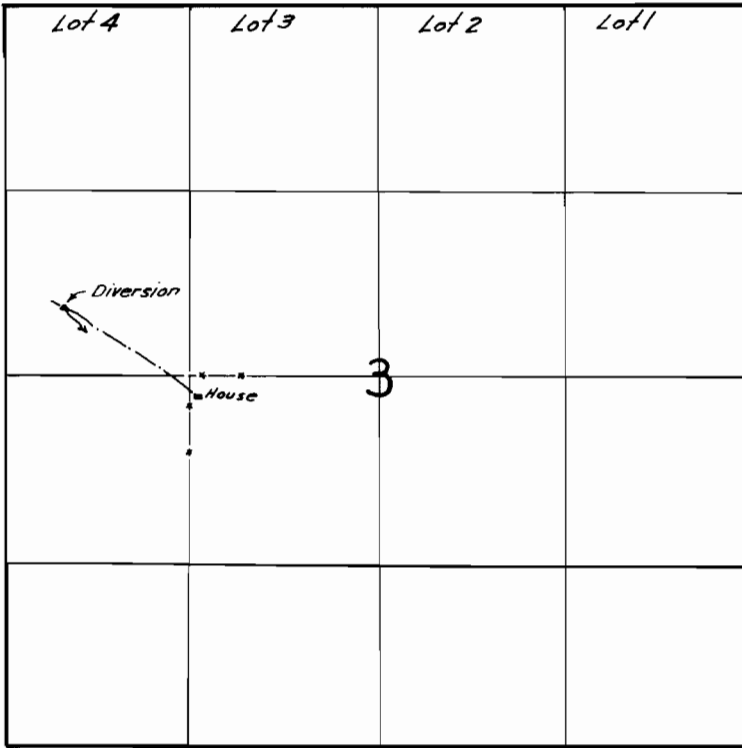

FINAL PROOF SURVEY
UNDER

Application No. 18643 Permit No. 14278

IN NAME OF

Fred G. Dick

Surveyed Aug. 9, 1941, by Chester A. Cummings