

T. 11 S. R. 21 E.

T. 11 S. R. 22 E.

Bridge Creek

Range Line

MITCHELL.

Keys Cr.

Township Line

Hollow

Orchard

18 95' R. 3/4 corner
N. 68° W. - 15.00 To Sasser Orchard Fence

N. 63 1/2° W. - 7.53

Reservoir 60x60' Fence

N. 32° W. - 10.12
N. 40° W. - 5.19

N. 40° W. - 4.64
N. 32 1/2° W. - 7.57

T. 12 S. R. 21 E.

N. 32 1/2° W. 80.00 - 3/4

T. 12 S. R. 22 E.

N. 18° W. - 77.12

N. 10 1/2° W. - 70.62

N. 4 3/4° W. - 60.75

N. 4 3/4° W. - 59.32

N. 4 1/2° W. - 50.32

N. 3 1/4° W. - 39.67

N. 17° W. - 33.92

N. 15 1/2° W. - 23.48

N. 13° W. - 18.95

N. 14° W. - 17.48

N. 30° W. - 5.28

N. 68 1/2° E. -


Mitchell proposed pipe line

Bridge Cr.

1/4

3/4

7.59

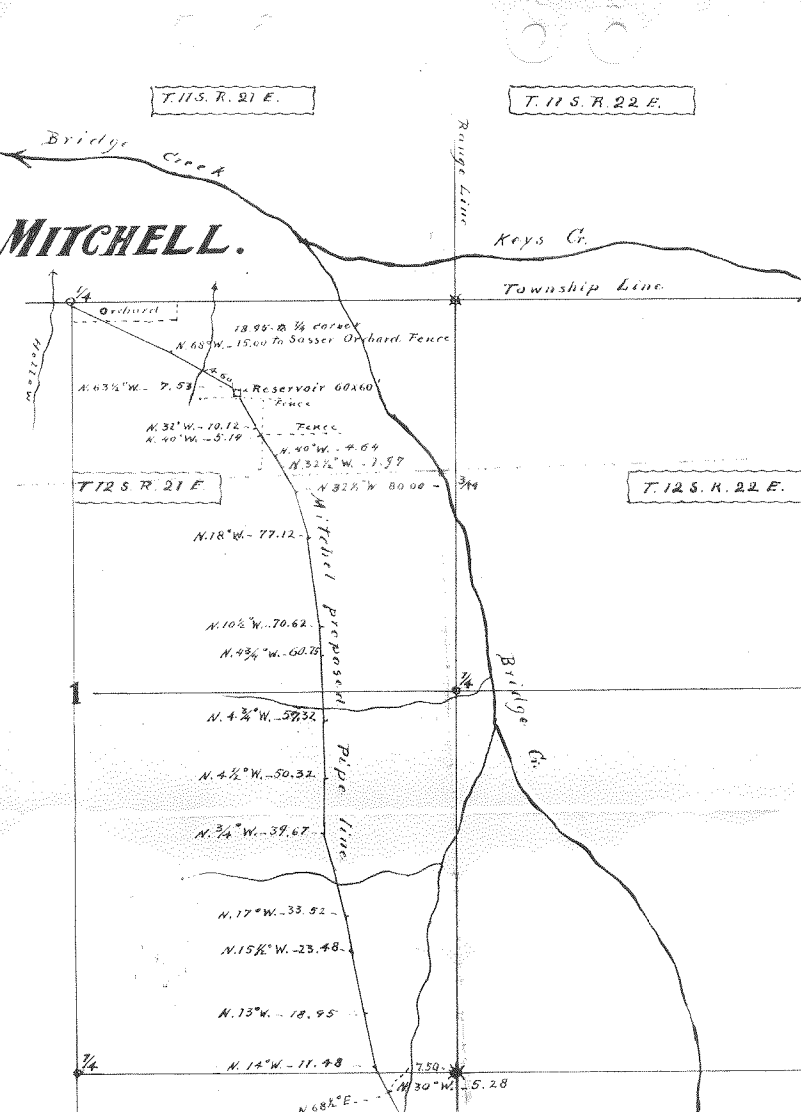

N. 73° W. - 18.95

N. 14° W. - 17.48

N. 68 1/2° E. - - -

7.50
N. 30° W. - 5.28

N. 40° W. - 2.28 BE Angle
N. 40° W. - 40.00 - 2M
N. 30° W. - 78.98 TO Nelson Gulch

N. 26° W. - 70.78



Scale - 1" = 70 chs.

12

N. 26° W. - 66.72

N. 5 1/2° W. - 48.58

N. 12 1/2° E. - 32.26

N. 17 1/2° E. - 36.08

N. 6° E. - 33.28

N. 11° E. - 26.75

N. 36° E. - 27.48

N. 15° E. - 19.03

N. 8° E. - 12.85

N. 17 1/2° E. - 8.48

N. 9° E. - 2.98

N. 11° E. - 8.55

N. 11° E. - 88.00

N. 3 1/2° E. - 78.87

N. 9 1/2° W. - 78.58

N. 10 1/2° E. - 72.52

N. 16 1/2° E. - 70.83

N. 12 1/2° E. - 60.83

N. 15° W. - 62.48

N. 10 1/2° W. - 57.54

N. 21 1/2° E. - 55.48

N. 2° E. - 30.48

North - 47.25


L. H. C. Herdman, s.
Witness.


A. T. Sheppard
 1850

Sheppard West Ditch

N 92° E - 2.98
 N 114° E - 80.00 - 1/4
 N 3 1/2° E - 78.87
 N 9 1/2° W - 76.58
 N 104° E - 72.52

N 16° E - 70.83
 N 11° E - 66.88
 N 15° W - 62.48

N 21° E - 55.48

N 99° W - 57.54

N 2° E - 50.48

North - 47.28

N 39° E - 47.58

N 14° E - 45.08

N 10° E - 40.48

N 13 1/2° E - 36.98

N 15 1/2° E - 35.36

North - 34.44

N 2° E - 30.73

N 16° W - 27.18

N 10° W - 25.08

N 28° W - 23.75

N 26° W - 21.24

N 3° E - 20.45

N 17° E - 21.48

N 8 1/2° E - 18.62

N 16° W - 17.65

N 18° W - 16.75

N 10° W - 16.48

N 28° E - 13.74

N 46° E - 12.48

N 9° E - 12.28

N 42° E - 11.60

N 10° W - 10.37

N 8 1/2° W - 9.60

N 3° W - 8.25

N 1 1/2° E - 6.90

N 10 1/2° E - 5.50

N 37° W - 4.90

N 18° E - 75.38

N 31 1/2° E - 18.11

N 17° W - 7.50

N 5° W - 6.25

N 50 1/2° W - 3.00

N 28° W - 2.75

Cross T. & S. West Ditch

Headgate of Taylor & Sheppard West Ditch
 and S. 62° E - 23 lks to T. & S. Headgate

Headgate at Pipe line

Nelson Reservoir Branch

HOLLOW

13

18

36
20

3000

3000