


T 4 S., R. 5 E.

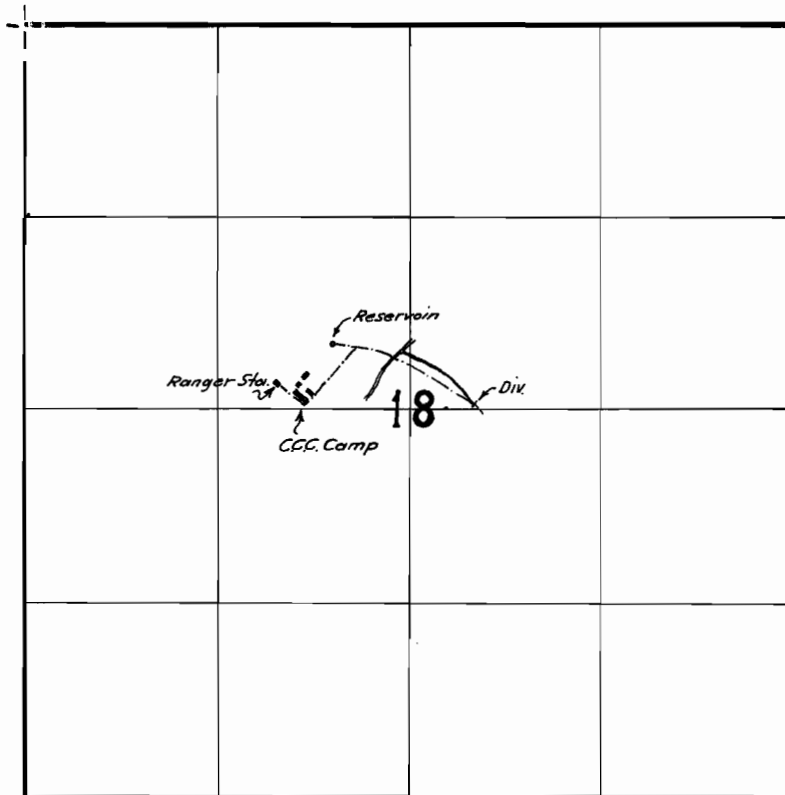

FINAL PROOF SURVEY
UNDER

Application No. 18725 Permit No. 14342

IN NAME OF

Mt. Hood National Forest

Surveyed Aug 21, 1941, by Chester Cummings