


TOWNSHIP 7 N., RANGE 2 W.

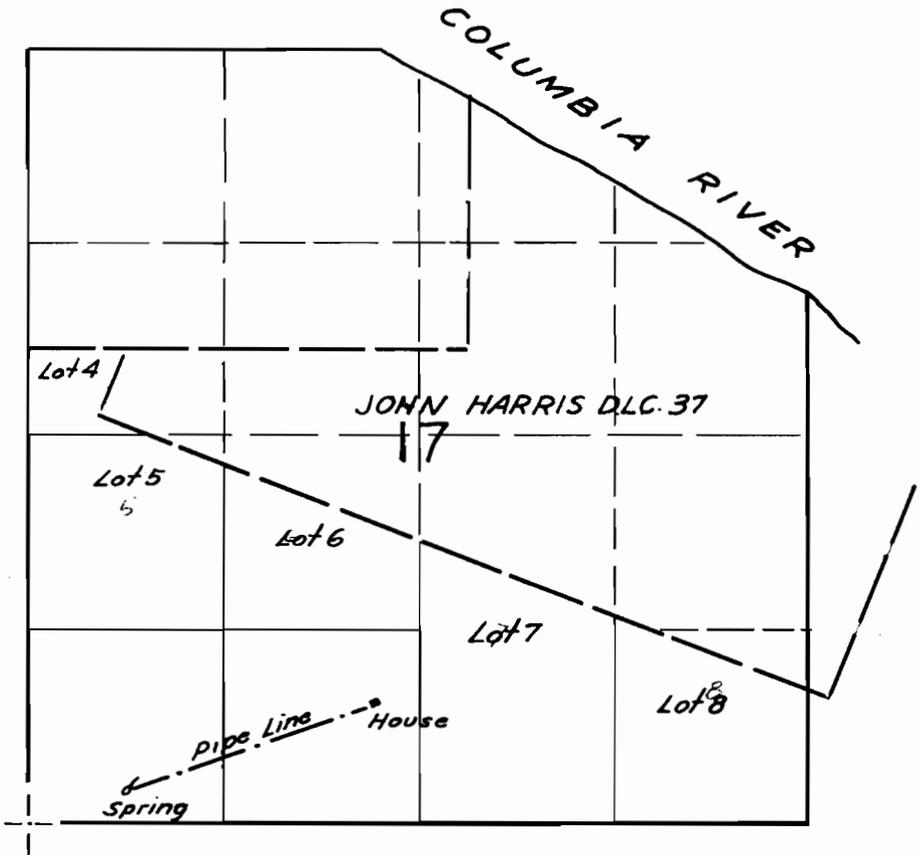

FINAL PROOF SURVEY
UNDER

Application No. 18728 Permit No. 14343

IN NAME OF

George J. Winters

Surveyed Aug. 12, 1941, by Chester Cummings