


TOWNSHIP 5 S., RANGE 5 W.

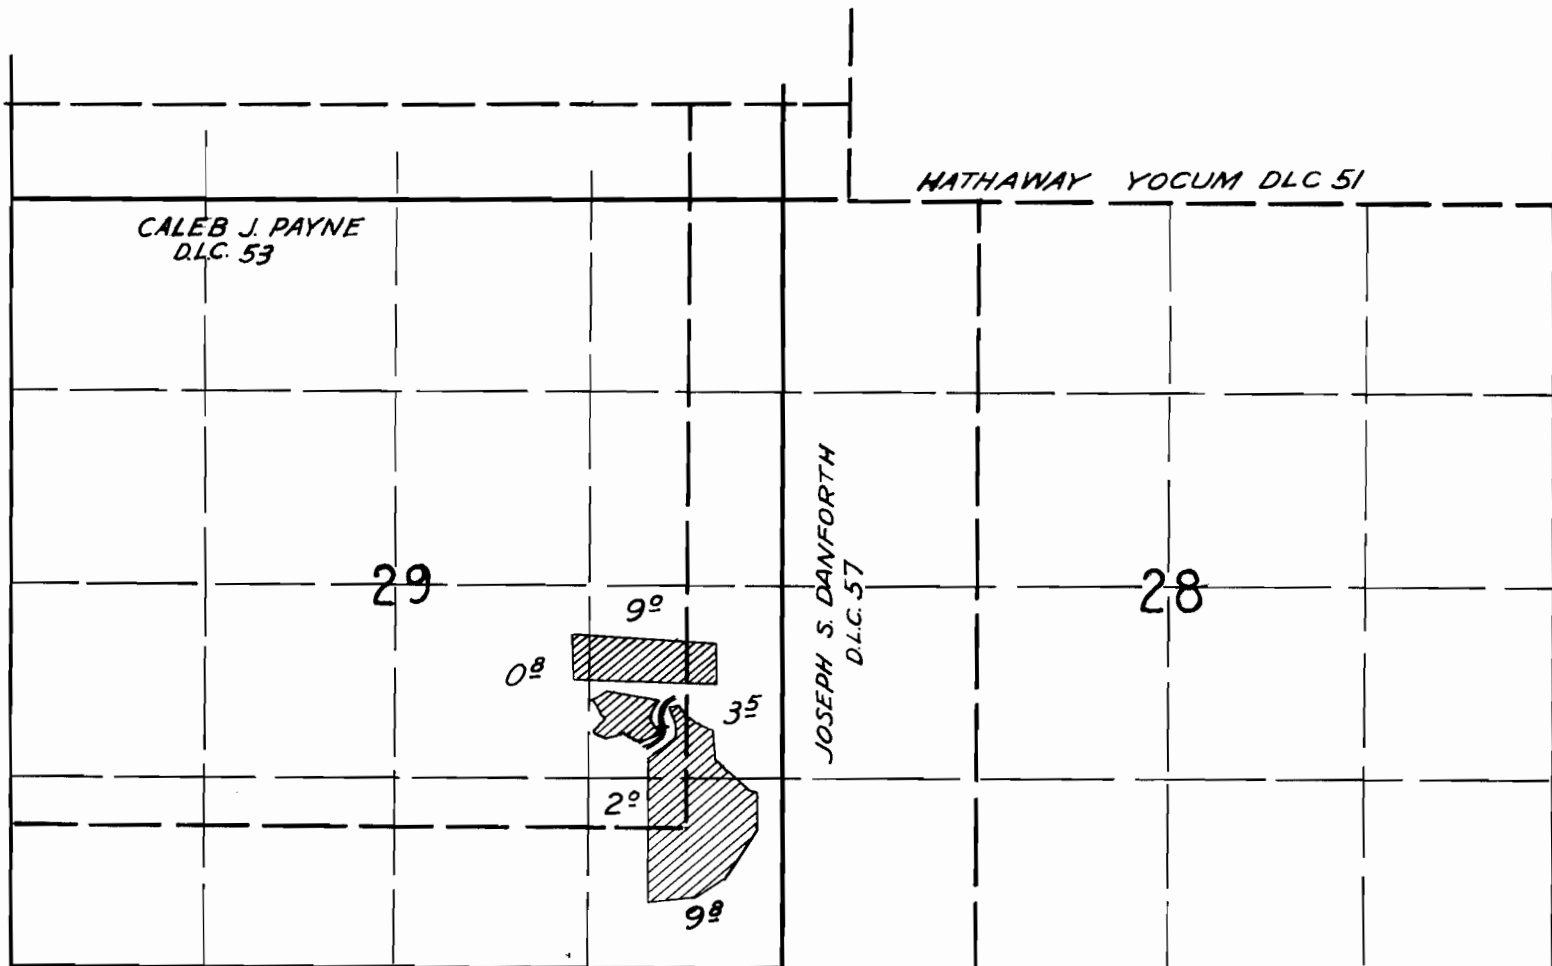

FINAL PROOF SURVEY
UNDER

Application No. 18103 Permit No. 13759

IN NAME OF

Lawrence Buel

Surveyed Apr. 26, 1941, by Chas. Cummins

R-22277