


TOWNSHIP 9S, R4E.

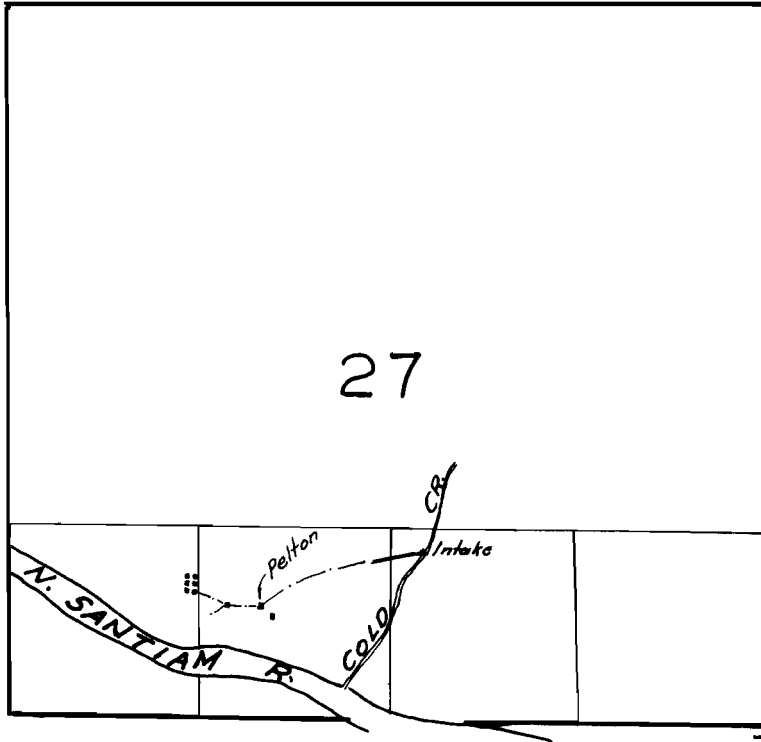

Traced from adjudication Map

**FINAL PROOF SURVEY
UNDER**

Application No. 18879 Permit No. 14384

IN NAME OF

Peter Nystrom

Surveyed May 15, 1941, by Ed Humming