


TOWNSHIP 13 S., RANGE 11 W.

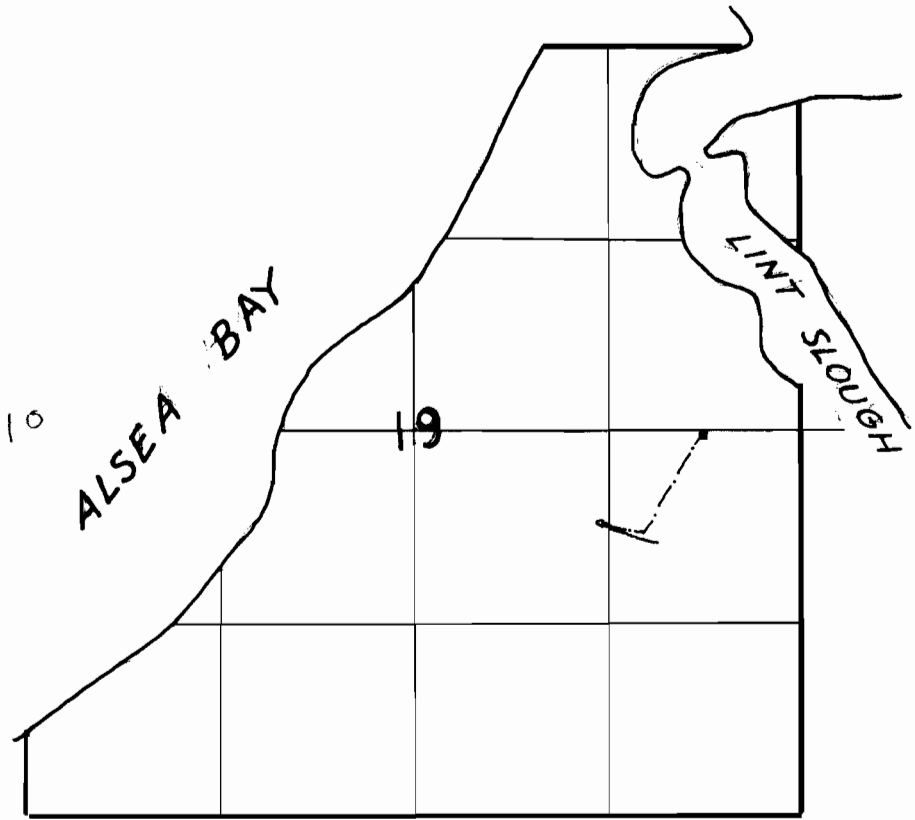

FINAL PROOF SURVEY
UNDER

Application No. 18766 Permit No. 14415

IN NAME OF

B. A. Baldwin

Surveyed Aug 7, 1941, by C. Manning