


TOWNSHIP 9 S. RANGE 34 E.

Per 14417
14297

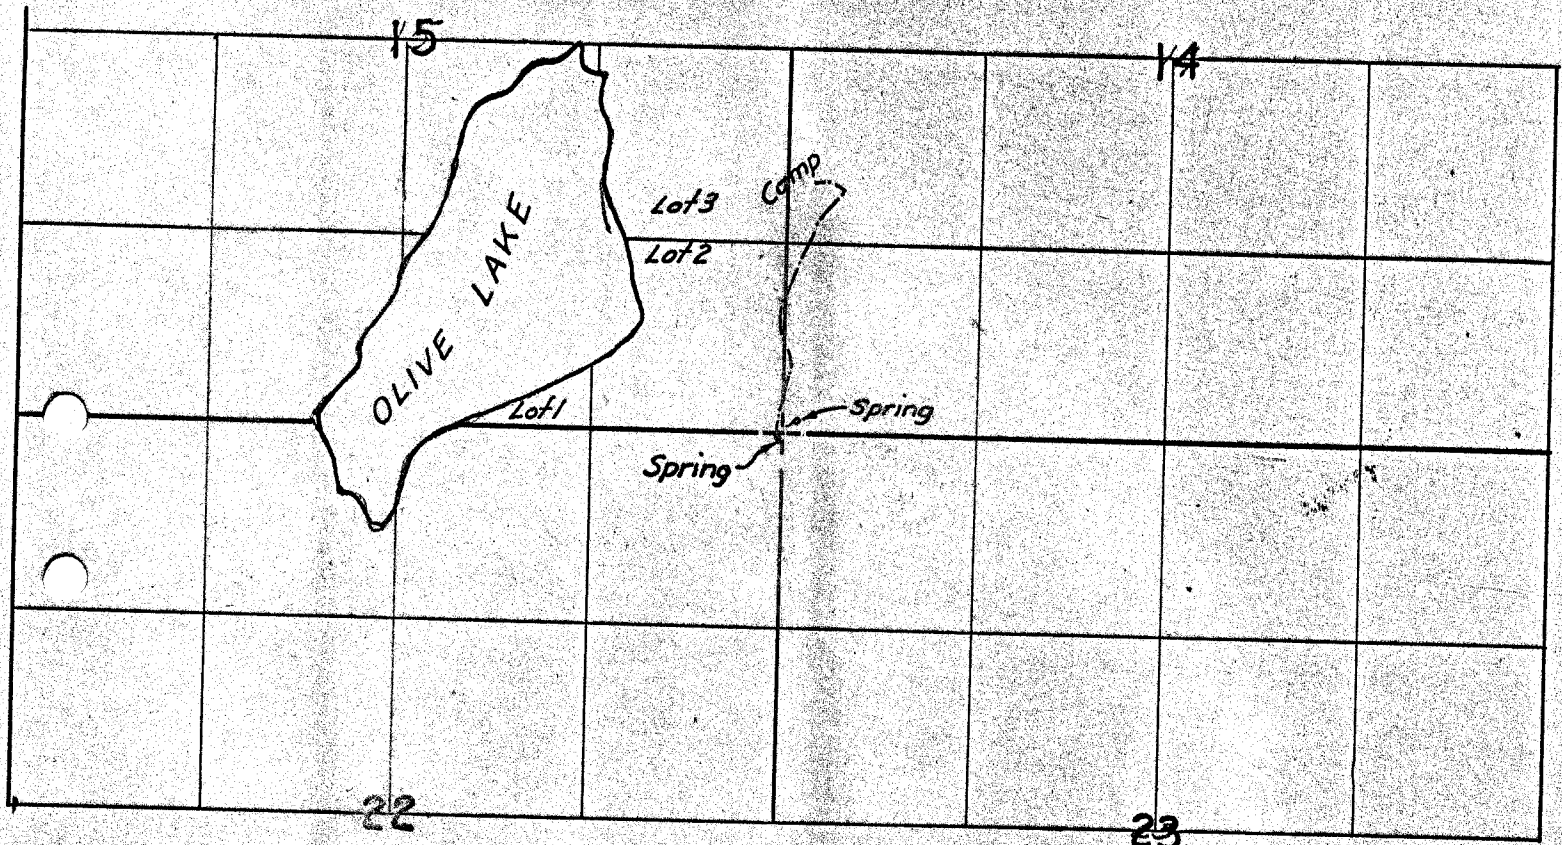

FINAL PROOF SURVEY
UNDER

Application No. 18768 Permit No. 14417
IN NAME OF

Whitman National Forest

Surveyed July 31, 1941, by Chas. Cummings