


TOWNSHIP 1 N., RANGE 5 E.

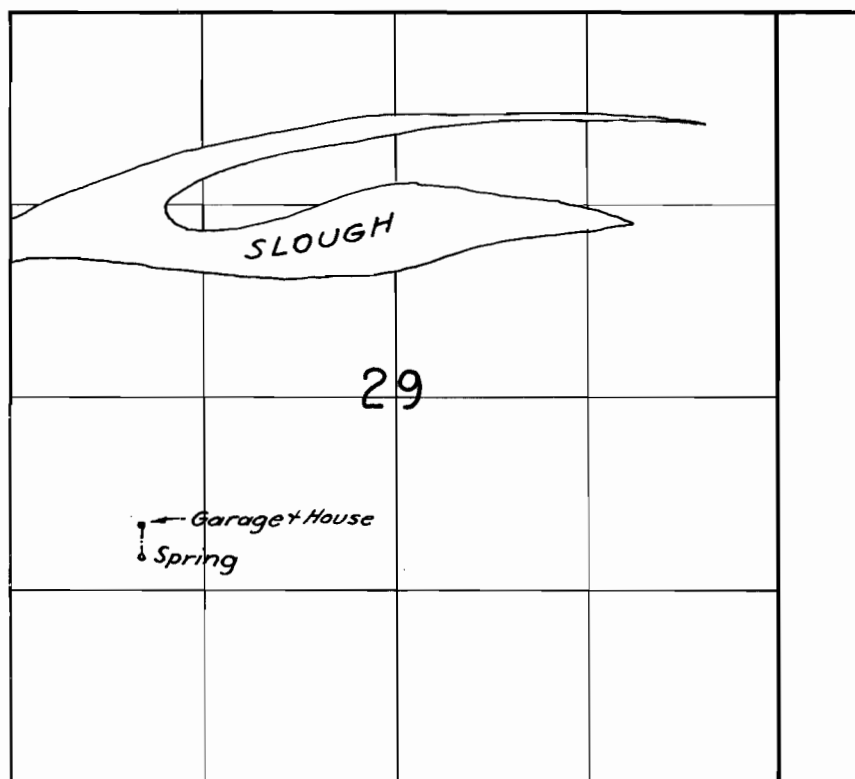

FINAL PROOF SURVEY

UNDER

Application No. 18782 Permit No. 14427

IN NAME OF

George W. Joseph

Surveyed July 3 1941, by *Chas. H. Cumming*