


TOWNSHIP 9 S., RANGE 3 E.

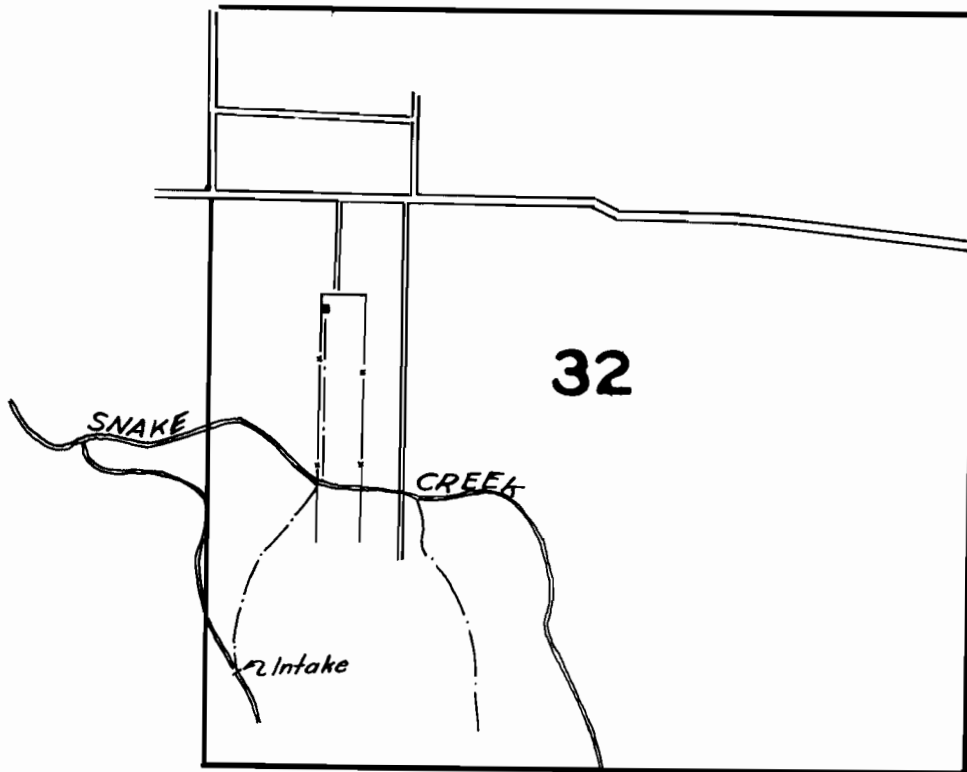

FINAL PROOF SURVEY
UNDER

Application No. 18863 Permit No. 14496

IN NAME OF

S. G. Higdon

Surveyed May 16 1941, by Blumming