


TOWNSHIP 8 S., RANGE 3 W.

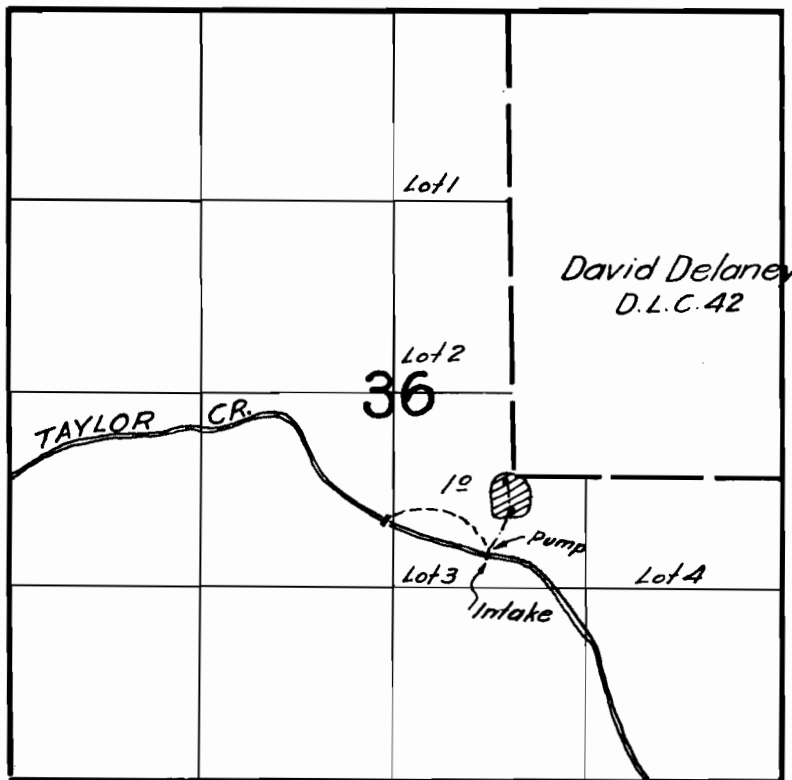

FINAL PROOF SURVEY
UNDER

Application No. 18914 Permit No. 14525

IN NAME OF

Leo H. Johnson

Surveyed May 15 1941, by [Signature]