


TOWNSHIP 9 S., RANGE 4E.

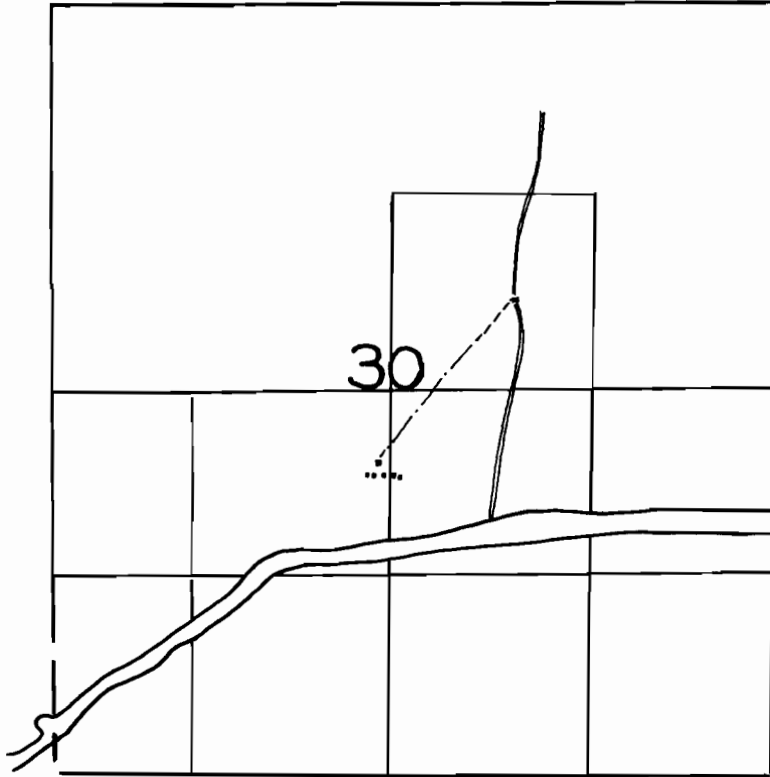

FINAL PROOF SURVEY

UNDER

Application No. 18947 Permit No. 14549

IN NAME OF

Fred C. Stone

Surveyed May 15 1941, by Ed Cummings