


TOWNSHIP 11S., RANGE 2E.

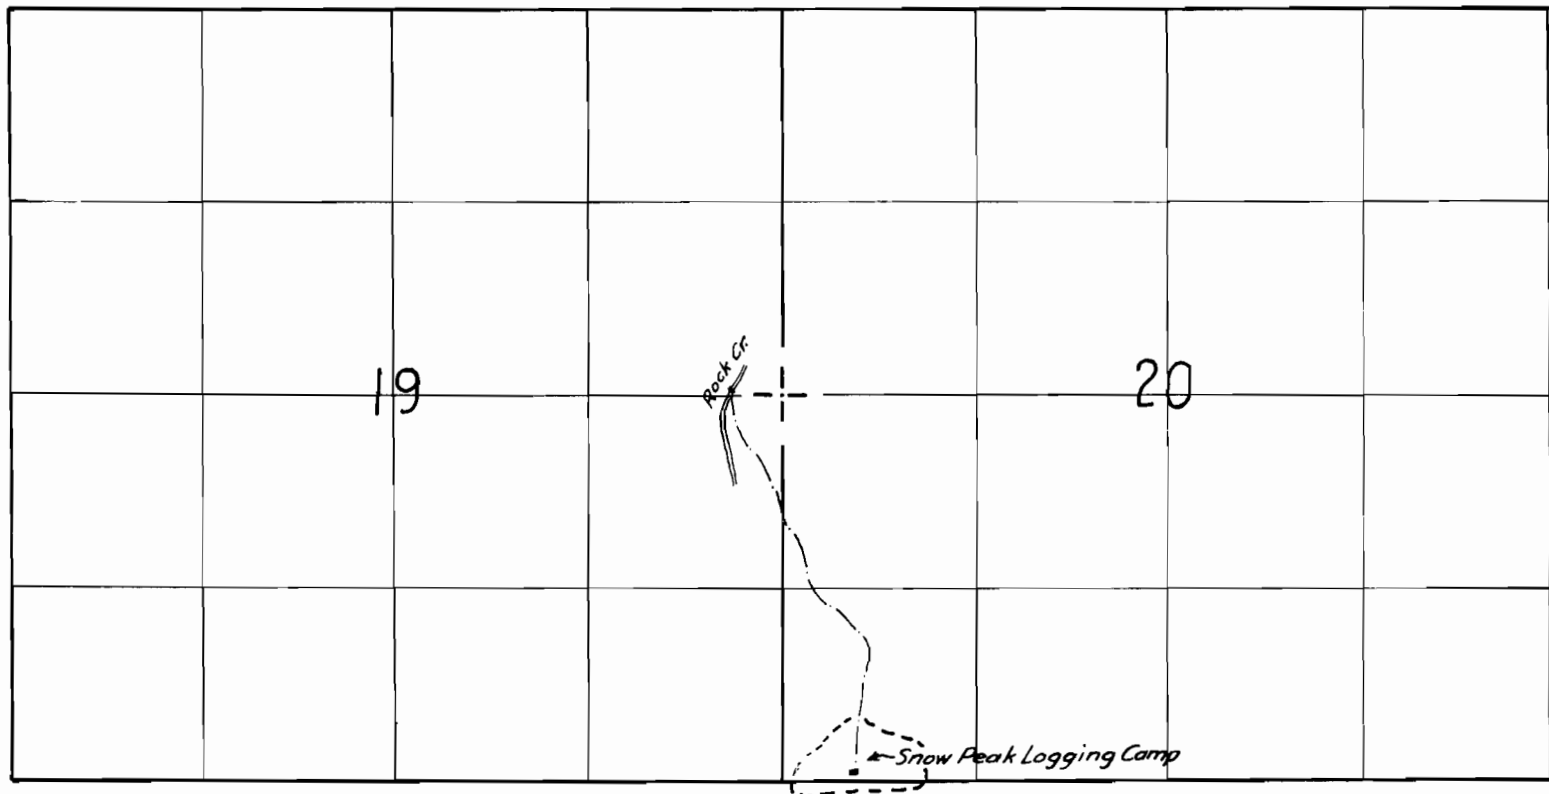

FINAL PROOF SURVEY
UNDER

Application No. 18944 Permit No. 14547

IN NAME OF

Willamette Valley Lumber Co.

Surveyed May 20 1941, by C. W. Manning