


TOWNSHIP 11 S., RANGE 1 E.

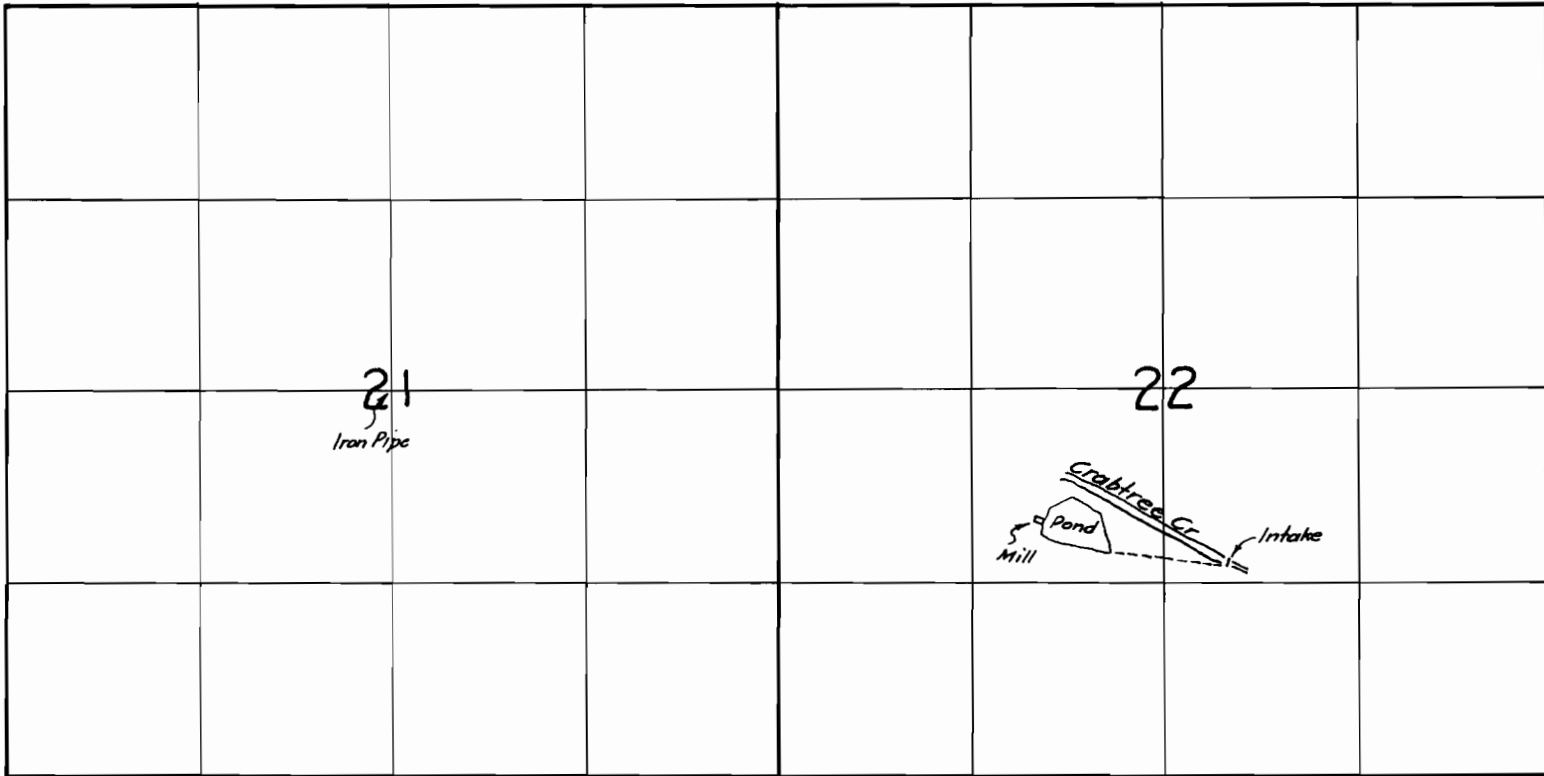

FINAL PROOF SURVEY
UNDER

Application No. 18965 Permit No. 14564

IN NAME OF

Hammond Lumber Company

Surveyed May 19, 1941, by E. C. Cummings